

Status of Road Construction  
 Existing Section km 23+800 to km 30+200 (6400m)  
 Construction Status : EW in Excavation Observed  
 Usable Length as per Proposed Revised DPR  
 Proposed CL as per Revised DPR  
 Existing Carriageway  
 Existing Roadway Towards Hill Side  
 Existing Roadway Towards Valley Side  
 Excavation by Contractor  
 Proposed Corridor

| |
|---|
| PROPOSED LEVEL (FRL)    | 551.547  | 550.620 | 549.293           | 547.700 | 546.100             | 544.500              | 543.001          | 541.680            | 540.477            | 539.277 | 538.076 | 536.776             | 535.297           | 533.700              | 532.244            | 531.362              | 529.476 | 530.513 | 529.039            | 527.697 | 526.477 | 525.277 | 524.077           | 522.877 | 521.677 | 520.477 | 519.277            | 518.077 | 516.877 | 515.677 | 514.477 | 513.277 | 512.079 | 510.956 | 509.946 | 509.020 | 508.100 | 507.180 | 506.260 | 505.340 | 504.420 | 503.474 | 502.298 | 500.849 | 499.250 | 497.650 | 496.065 | 494.704 | 493.637 | 492.897 | 491.757 | 490.817 | 489.877 |
| EXISTING LEVEL (NGL)    | 551.597  | 550.477 | 548.042           | 543.958 | 544.377             | 543.166              | 541.912          | 539.644            | 537.701            | 536.516 | 535.438 | 534.428             | 533.182           | 532.244              | 531.362            | 529.476              | 528.108 | 525.864 | 524.372            | 523.673 | 522.877 | 521.677 | 519.639           | 518.366 | 516.706 | 515.642 | 514.555            | 513.323 | 512.370 | 511.332 | 510.377 | 509.596 | 509.083 | 507.584 | 506.557 | 505.707 | 498.997 | 505.649 | 516.881 | 502.153 | 497.046 | 497.948 | 496.865 | 497.999 | 490.260 | 490.423 | 493.213 | 496.588 | 499.702 | 488.772 |         |         |         |
| LEVEL DIFF. (FRL - NGL) | -0.051   | 0.142   | 1.252             | 3.742   | 1.723               | 1.332                | 1.090            | 2.035              | 2.775              | 2.760   | 2.638   | 2.347               | 2.115             | 1.456                | 0.737              | 1.037                | 0.830   | 1.834   | 2.105              | 1.603   | 1.510   | 1.996   | 1.613             | 0.838   | 0.908   | 1.370   | 1.235              | 1.121   | 1.154   | 0.907   | 0.746   | 0.580   | 0.349   | -0.062  | 0.517   | 0.623   | 0.553   | 6.344   | -1.229  | -13.207 | 0.145   | 3.803   | 1.301   | 0.784   | -1.935  | 4.445   | 3.214   | -0.517  | -4.831  | -8.885  | 1.104   |         |         |
| HORIZONTAL              | R=33.0m<br>L=71.5m   |         | L=104.3m          |         | R=110.0m<br>L=34.2m | R=175.0m<br>L=140.9m |                  | R=38.0m<br>L=59.4m | R=43.0m<br>L=92.3m |         | L=41.0m | R=59.5m<br>L=161.9m |                   | R=130.0m<br>L=141.4m |                    | R=100.0m<br>L=107.9m |         | R       | L                  |         |         
| SUPERELEVATION          | 7.00%  |         | 2.50%             |         | 3.64%               |                      | 2.50%            |                    | 7.00%              |         | 7.00%   |                     | 2.50%             |                      | 6.72%              |                      | 3.08%   |         | 4.00%              |         | -7.00%  |         | -2.50%            |         | -6.72%  |         | -3.08%             |         | -4.00%  |         |         
| CURVE WIDENING          | 6.5  |         | 5.8               |         | 5.8                 |                      | 6.2              |                    | 6.2                |         | 5.8     |                     | 5.9               | |
| VERTICAL SCHEMATIC      | L=45.0m  |         | G=-8.0<br>L=55.0m |         | L=45.0m             |                      | G=6.0<br>L=55.0m |                    | L=45.0m            |         | L=47.5m |                     | G=-8.0<br>L=60.0m |                      | G=-6.0<br>L=245.0m |                      | L=50.0m |         | G=-4.6<br>L=125.0m |         | L=50.0m |         | G=-8.0<br>L=52.5m |         | L=45.0m |         | G=-4.7<br>L=122.5m |         |         
| WIDENING/IMP PROPOSAL   | Widening on Right Side (Valley) with Geometric Improvement<br>BC = 30mm , DBM = 50mm , WMM = 250mm , GSB = 150mm , SG = 500mm ( CBR > 8% @ 97% @ MDD ) | |
| CHAINAGE                | 24+000   | 24+020  | 24+040            | 24+060  | 24+080              | 24+100               | 24+120           | 24+140             | 24+160             | 24+180  | 24+200  | 24+220              | 24+240            | 24+260               | 24+280             | 24+300               | 24+320  | 24+340  | 24+360             | 24+380  | 24+400  | 24+420  | 24+440            | 24+460  | 24+480  | 24+500  | 24+520             | 24+540  | 24+560  | 24+580  | 24+600  | 24+620  | 24+640  | 24+660  | 24+680  | 24+700  | 24+720  | 24+740  | 24+760  | 24+780  | 24+800  | 24+820  | 24+840  | 24+860  | 24+880  | 24+900  | 24+920  | 24+940  | 24+960  | 24+980  | 25+000  |         |         |

Notes :  
 1) All Levels are in m unless otherwise indicated.

|                         |                                   |
|-------------------------|-----------------------------------|
| Proposed CL :           | Existing Road :                   |
| Proposed CW :           | Existing Hill :                   |
| Contours 20m Interval : | Existing Valley :                 |
| Contours 5m Interval :  | Existing Hill Cutting Line :      |
| Proposed Major Bridge : | Existing Hill Toe Line :          |
| Proposed Minor Bridge : | Existing Valley Line :            |
| Proposed Pipe Culvert : | Important Buildings :             |
| Proposed Slab Culvert : | Other Buildings/Huts/Tile house : |
| Proposed Box Culvert :  |                                   |

|          |           |                 |            |          |       |           |                 |
|----------|-----------|-----------------|------------|----------|-------|-----------|-----------------|
| R0       | Sep. 2017 | Tender Drawings | NKM / RJ   | DR       | DR    | NKS & SKB | Tapas Mukherjee |
| Revision | Date      | Stage / Report  | Topography | Designed | Drawn | Checked   | Approved        |

Client : Ministry of Road Transport & Highways (Government of India)  
 Consultant : RITES LIMITED, RITES BHAWAN, Plot No. 1, Sector- 29, Gurgaon-122001

Project : Preparation of Revised Detailed Project Report and Verification of Executed Quantities/Items for Widening to 2 Lane of Merangkong-Tamlu-Mon Road, Changtongya-Longleng Road, Chakabama-Zunhebot Road & Pftusero-Phek Road under Phase 'A' of SARDP-NE in the State of Nagaland

Scale : Horizontal 1:50, 1:75, 1:100  
 Vertical 1:5, 1:7.5, 1:10


Title : ALIGNMENT PLAN & PROFILE : MERANGKONG TAMLU MON ROAD

Page No. : MTM -25



MERANGKONG

MON

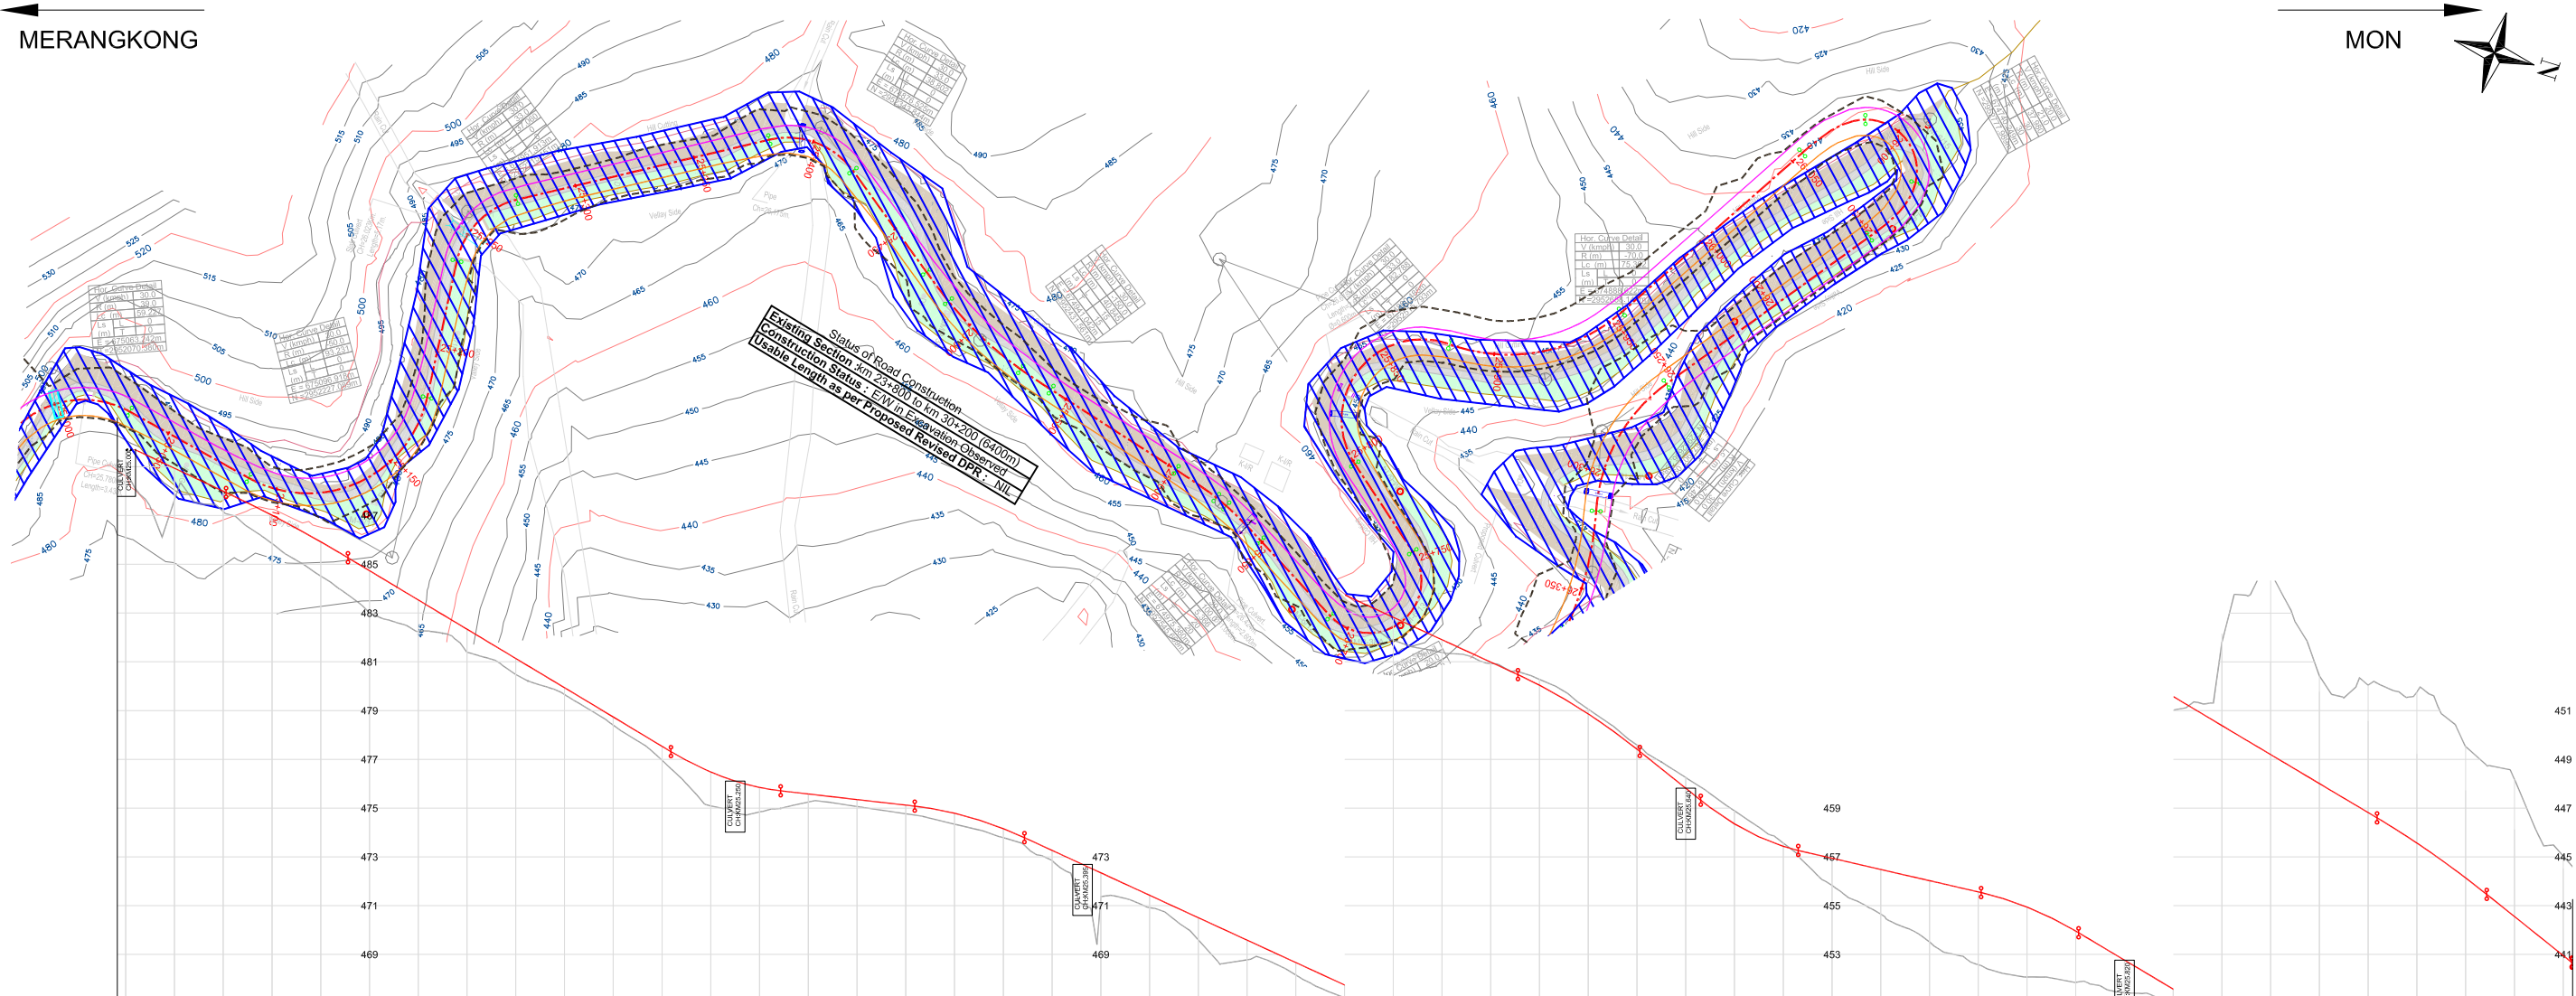

| |
|---|
| PROPOSED LEVEL (FRL)    | 488.877  | 488.937 | 487.997 | 487.010 | 485.920  | 484.737 | 483.537  | 482.337 | 481.137 | 479.937 | 478.737 | 477.537 | 476.481  | 475.849 | 475.560 | 475.351 | 475.122  | 474.791 | 474.158 | 473.267 | 472.347 | 471.427 | 470.507 | 469.587 | 468.667 | 467.747 | 466.827 | 465.907 | 464.987   | 464.040 | 462.864 | 461.416 | 459.816  | 458.353 | 457.432 | 456.945 | 456.025 | 455.485 | 454.943 | 453.957 | 452.767  | 451.577 | 450.387 | 449.197 | 448.007 | 446.817 | 445.567 | 444.137 | 442.554 | 440.957 |        |  |  |  |  |  |
| EXISTING LEVEL (NGL)    | 488.772  | 487.639 | 487.162 | 485.854 | 484.517  | 483.015 | 482.244  | 481.395 | 480.478 | 479.658 | 478.400 | 477.961 | 475.089  | 474.845 | 475.249 | 475.065 | 474.767  | 474.342 | 473.787 | 472.848 | 471.306 | 470.917 | 471.427 | 469.596 | 468.781 | 468.157 | 467.226 | 465.985 | 465.380   | 464.930 | 464.278 | 464.040 | 463.059  | 461.589 | 460.252 | 458.886 | 457.568 | 456.837 | 454.654 | 453.514 | 452.579  | 452.075 | 451.855 | 451.435 | 451.015 | 450.784 | 450.675 | 449.524 | 448.187 | 445.035 |        |  |  |  |  |  |
| LEVEL DIFF. (FRL - NGL) | 1.104  | 1.297   | 0.835   | 1.156   | 1.404    | 1.721   | 1.293    | 0.941   | 0.659   | 0.279   | 0.336   | 0.575   | 1.392    | 1.004   | 0.330   | 0.286   | 0.355    | 0.450   | 0.370   | 0.419   | 1.040   | 0.510   | 0.911   | 0.806   | 0.510   | 0.521   | 0.942   | 0.526   | 0.057   | -0.238  | -0.196  | -0.174  | -0.435   | -0.534  | -0.136  | 1.107   | 1.830   | 2.510   | 2.985   | 2.868   | 2.102    | 1.332   | 0.562   | -3.396  | -7.477  | -4.416  | -5.227  | -6.197  | -5.388  | -5.633  | -4.081 |  |  |  |  |  |
| HORIZONTAL              | R=39.0m  |         | L=59.2m |         | L=55.9m  |         | R=-50.0m |         | L=93.2m |         | L=57.4m |         | R=33.0m  |         | L=37.1m |         | L=106.4m |         | R=33.0m |         | L=38.8m |         | L=51.4m |         | L=15.0m |         | L=40.8m |         | L=15.0m   |         | L=61.0m |         | L=20.0m  |         | L=20.0m |         | L=42.3m |         | L=64.0m |         | R=-21.5m |         | L=43.1m |         | L=82.8m |         | R=70.0m |         | L=75.4m |         |        |  |  |  |  |  |
| SUPERELEVATION          | 7.00%  |         | 2.50%   |         | 7.00%    |         | 2.50%    |         | 7.00%   |         | 2.50%   |         | 7.00%    |         | 2.50%   |         | 2.67%    |         | 2.50%   |         | 4.00%   |         | 2.50%   |         | 7.00%   |         | 2.50%   |         | 7.00%   |         | 2.50%   |         | -4.00%   |         | -2.50%  |         | 7.00%   |         | 2.50%   |         | 7.00%    |         | -7.00%  |         | -5.71%  |         | 5.71%   |         |         |         |        |  |  |  |  |  |
| CURVE WIDENING          | 6.5  |         | 6.5     |         | 6.2      |         | 6.5      |         | 6.5     |         | 6.5     |         | 6.5      |         | 6.5     |         | 6.5      |         | 6.5     |         | 6.5     |         | 6.5     |         | 6.5     |         | 6.5     |         | 6.5   |         | 6.5     |         | 6.5      |         | 6.5     |         | 6.5     |         | 6.5     |         | 6.5      |         | 6.5     |         | 6.5     |         |         |         |         |         |        |  |  |  |  |  |
| VERTICAL SCHEMATIC      | L=50.0m  |         | G=-6.0  |         | L=132.5m |         | L=45.0m  |         | G=-1.1  |         | L=45.0m |         | L=202.5m |         | G=-4.6  |         | L=50.0m  |         | L=25.0m |         | G=-8.0  |         | L=40.0m |         | G=-2.3  |         | L=75.0m |         | L=40.0m   |         | G=-6.0  |         | L=122.5m |         | L=45.0m |         | G=-8.0  |         | L=35.0m |         |          |         |         |         |         |         |         |         |         |         |        |  |  |  |  |  |
| WIDENING/IMP PROPOSAL   | Widening on Right Side (Valley) with Geometric Improvement |         |         Widening on Left Side (Hill) with Geometric Improvement |         |         
| CHAINAGE                | 25+000   | 25+020  | 25+040  | 25+060  | 25+080   | 25+100  | 25+120   | 25+140  | 25+160  | 25+180  | 25+200  | 25+220  | 25+240   | 25+260  | 25+280  | 25+300  | 25+320   | 25+340  | 25+360  | 25+380  | 25+400  | 25+420  | 25+440  | 25+460  | 25+480  | 25+500  | 25+520  | 25+540  | 25+560  | 25+580  | 25+600  | 25+620  | 25+640   | 25+660  | 25+680  | 25+700  | 25+720  | 25+740  | 25+760  | 25+780  | 25+800   | 25+820  | 25+840  | 25+860  | 25+880  | 25+900  | 25+920  | 25+940  | 25+960  | 25+980  | 26+000 |  |  |  |  |  |

Notes :  
1) All Levels are in m unless otherwise indicated.

Legend :

- Proposed CL : [Red line]
- Proposed CW : [Blue line]
- Contours 20m Interval : [Red line]
- Contours 5m Interval : [Blue line]
- Proposed Major Bridge : [Green rectangle]
- Proposed Minor Bridge : [Blue rectangle]
- Proposed Pipe Culvert : [Blue rectangle]
- Proposed Slab Culvert : [Blue rectangle]
- Proposed Box Culvert : [Blue rectangle]
- Existing Road : [Grey line]
- Existing Hill : [Green area]
- Existing Valley : [Blue area]
- Existing Hill Cutting Line : [Red line]
- Existing Hill Toe Line : [Red line]
- Existing Valley Line : [Red line]
- Important Buildings : [Orange rectangle]
- Other Buildings/Huts/Tile house : [Blue rectangle]

|          |           |                 |            |          |       |           |                 |
|----------|-----------|-----------------|------------|----------|-------|-----------|-----------------|
| R0       | Sep. 2017 | Tender Drawings | NKM / RJ   | DR       | DR    | NKS & SKB | Tapas Mukherjee |
| Revision | Date      | Stage / Report  | Topography | Designed | Drawn | Checked   | Approved        |

Client : Ministry of Road Transport & Highways (Government of India)

Consultant : RITES LIMITED, RITES BHAWAN, Plot No. 1, Sector- 29, Gurgaon-122001

Project : Preparation of Revised Detailed Project Report and Verification of Executed Quantities/Items for Widening to 2 Lane of Merangkong-Tamlu-Mon Road, Changtongya-Longleng Road, Chakabama-Zunheboto Road & Putsero-Phek Road under Phase 'A' of SARDP-NE in the State of Nagaland


Scale : Horizontal 1:50, 1:75, 1:100; Vertical 1:5, 1:7.5, 1:10

Title : ALIGNMENT PLAN & PROFILE : MERANGKONG TAMLU MON ROAD

Page No. : MTM-26

MERANGKONG

MON

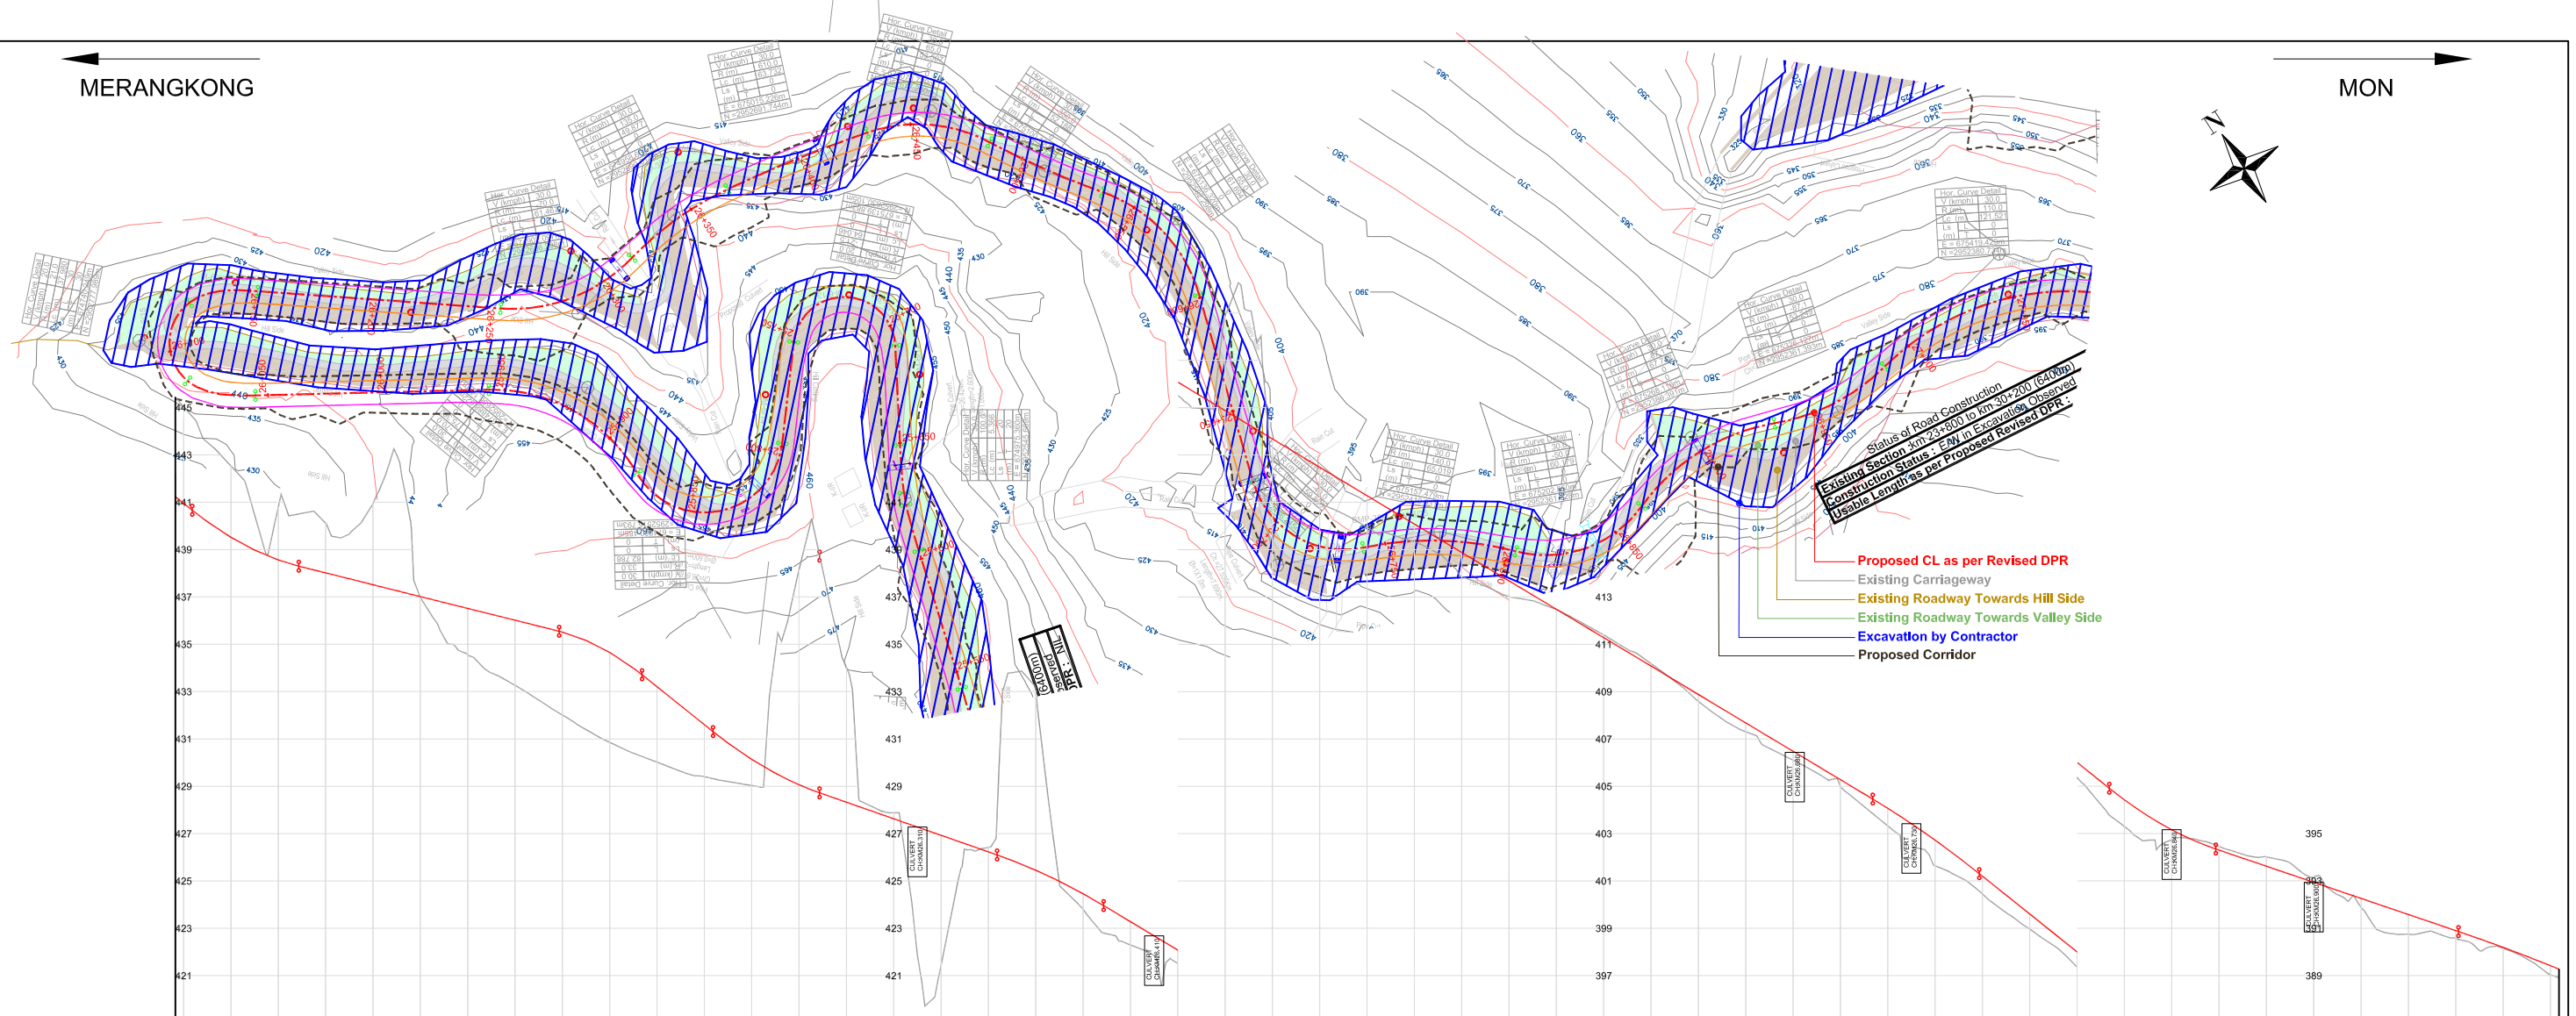

Status of Road Construction  
 Usable Lengths per Proposed Revised DPR:

- Proposed CL as per Revised DPR
- Existing Carriageway
- Existing Roadway Towards Hill Side
- Existing Roadway Towards Valley Side
- Excavation by Contractor
- Proposed Corridor

| |
|---|
| PROPOSED LEVEL (FRL)    | 440.954   | 440.954 | 439.517 | 438.561 | 438.015            | 437.515 | 437.015 | 436.515 | 436.015  | 435.513 | 434.657  | 433.204 | 431.804            | 430.137 | 429.064             | 428.326 | 427.626             | 426.926 | 426.226            | 425.452 | 424.460             | 423.280 | 422.080            | 420.880 | 419.680 | 418.480 | 417.280            | 416.080 | 414.880             | 413.680 | 412.480            | 411.280 | 410.080            | 408.880 | 407.680            | 406.480 | 405.280 | 404.071 | 402.726 | 401.204 | 399.604 | 398.004 | 396.424 | 395.158 | 394.300 | 393.620 | 392.940 | 392.260 | 391.580 | 390.900 | 390.192 | 389.419 |
| EXISTING LEVEL (NGL)    | 443.035   | 442.531 | 440.793 | 440.113 | 440.942            | 436.997 | 434.563 | 433.263 | 432.012  | 430.855 | 430.019  | 429.407 | 429.031            | 438.159 | 434.035             | 427.881 | 426.420             | 433.031 | 423.796            | 422.295 | 421.513             | 424.897 | 418.837            | 416.970 | 415.942 | 415.337 | 413.854            | 413.017 | 412.471             | 411.400 | 410.182            | 408.588 | 407.308            | 406.107 | 405.003            | 403.330 | 401.643 | 400.454 | 399.968 | 397.358 | 395.300 | 394.732 | 394.464 | 394.013 | 393.169 | 391.888 | 390.754 | 390.574 | 390.153 | 389.036 |         |         |
| LEVEL DIFF. (FRL - NGL) | -4.081  | -3.015  | -2.233  | -2.099  | -3.428             | 0.018   | 1.951   | 2.751   | 3.501    | 3.801   | 3.185  | 2.197   | 1.106              | -9.096  | -5.709              | -0.254  | 5.490               | -0.194  | -7.579             | 0.663   | 0.985               | 0.568   | -4.017             | 0.843   | 1.510   | 1.339   | 0.743              | 1.026   | 0.664               | 0.009   | -0.119             | -0.102  | 0.292              | 0.373   | 0.373              | 0.278   | 0.741   | 1.084   | 0.750   | 0.636   | 0.645   | 1.125   | 0.426   | -0.164  | -0.392  | -0.228  | 0.372   | 0.827   | 0.327   | 0.038   | 0.383   |         |
| HORIZONTAL              | L=98.7m   |         | L=30.0m |         | R=21.0m<br>L=38.0m |         | L=30.0m |         | L=102.9m |         |  |         | R=70.0m<br>L=61.5m |         | R=135.0m<br>L=49.9m |         | R=610.0m<br>L=63.7m |         | R=65.0m<br>L=53.5m |         | R=350.0m<br>L=52.2m |         | R=65.0m<br>L=61.7m |         | L=82.1m |         | R=40.0m<br>L=59.9m |         | R=140.0m<br>L=65.0m |         | R=50.0m<br>L=60.2m |         | R=87.1m<br>L=67.7m |         | R=87.1m<br>L=53.2m |         |         |         |         |         |         |         |         |         |         |         |         |         |         |         |         |         |
| SUPERELEVATION          | 2.50%   |         | 7.00%   |         | -2.50%             |         | -7.00%  |         | 2.50%    |         |  |         | 5.71%              |         | 2.96%               |         | 2.50%               |         | 6.15%              |         | 2.50%               |         | 6.15%              |         | 2.50%   |         | 7.00%              |         | 2.86%               |         | 7.00%              |         | 4.59%              |         | 4.59%              |         |         |         |         |         |         |         |         |         |         |         |         |         |         |         |         |         |
| CURVE WIDENING          | 5.0   |         | 6.5     |         | 5.0                |         | 5.0     |         | 5.0      |         |  |         | 5.6                |         | 5.9                 |         | 5.9                 |         | 5.9                |         | 5.9                 |         | 5.9                |         | 5.9     |         | 5.9                |         | 5.9                 |         | 5.9                |         | 5.9                |         | 5.9                |         | 5.9     |         |         |         |         |         |         |         |         |         |         |         |         |         |         |         |
| VERTICAL SCHEMATIC      | L=45.0m   |         | G=2.5   |         | L=110.0m           |         | L=35.0m |         | G=8.0    |         | L=45.0m  |         | G=3.5              |         | L=75.0m             |         | L=45.0m             |         | G=6.0              |         | L=325.0m            |         | L=45.0m            |         | G=8.0   |         | L=45.0m            |         | G=3.4               |         | L=102.5m           |         | L=50.0m            |         |                    |         |         |         |         |         |         |         |         |         |         |         |         |         |         |         |         |         |
| WIDENING/IMP PROPOSAL   | Widening on Left Side (Hill) with Geometric Improvement |         |         |         |                    |         |         |         |          |         | Widening on Right Side (Hill) with Geometric Improvement | |
| CHAINAGE                | 26+000  | 26+020  | 26+040  | 26+060  | 26+080             | 26+100  | 26+120  | 26+140  | 26+160   | 26+180  | 26+200   | 26+220  | 26+240             | 26+260  | 26+280              | 26+300  | 26+320              | 26+340  | 26+360             | 26+380  | 26+400              | 26+420  | 26+440             | 26+460  | 26+480  | 26+500  | 26+520             | 26+540  | 26+560              | 26+580  | 26+600             | 26+620  | 26+640             | 26+660  | 26+680             | 26+700  | 26+720  | 26+740  | 26+760  | 26+780  | 26+800  | 26+820  | 26+840  | 26+860  | 26+880  | 26+900  | 26+920  | 26+940  | 26+960  | 26+980  | 27+000  |         |

Notes :  
 1) All Levels are in m unless otherwise indicated.

- Legend :
- Proposed CL : [Red line]
  - Proposed CW : [Blue line]
  - Contours 20m Interval : [Red line]
  - Contours 5m Interval : [Blue line]
  - Proposed Major Bridge : [Green line]
  - Proposed Minor Bridge : [Blue line]
  - Proposed Pipe Culvert : [Blue line]
  - Proposed Slab Culvert : [Blue line]
  - Proposed Box Culvert : [Blue line]
  - Existing Road : [Grey line]
  - Existing Hill : [Brown area]
  - Existing Valley : [Green area]
  - Existing Hill Cutting Line : [Red line]
  - Existing Hill Toe Line : [Red line]
  - Existing Valley Line : [Red line]
  - Important Buildings : [Orange box]
  - Other Buildings/Huts/Tile house : [Blue box]

|          |           |                 |            |          |       |           |                 |
|----------|-----------|-----------------|------------|----------|-------|-----------|-----------------|
| R0       | Sep. 2017 | Tender Drawings | NKM / RJ   | DR       | DR    | NKS & SKB | Tapas Mukherjee |
| Revision | Date      | Stage / Report  | Topography | Designed | Drawn | Checked   | Approved        |

Client : Ministry of Road Transport & Highways (Government of India)

Consultant : RITES LIMITED, RITES BHAWAN, Plot No. 1, Sector- 29, Gurgaon-122001

Project : Preparation of Revised Detailed Project Report and Verification of Executed Quantities/Items for Widening to 2 Lane of Merangkong-Tamlu-Mon Road, Changtongya-Longleng Road, Chakabama-Zunhebot Road & Pftusero-Phek Road under Phase 'A' of SARDP-NE in the State of Nagaland


Scale : Horizontal 1:50, 1:75, 1:100; Vertical 1:5, 1:7.5, 1:10

Title : ALIGNMENT PLAN & PROFILE : MERANGKONG TAMLU MON ROAD

Page No. : MTM-27







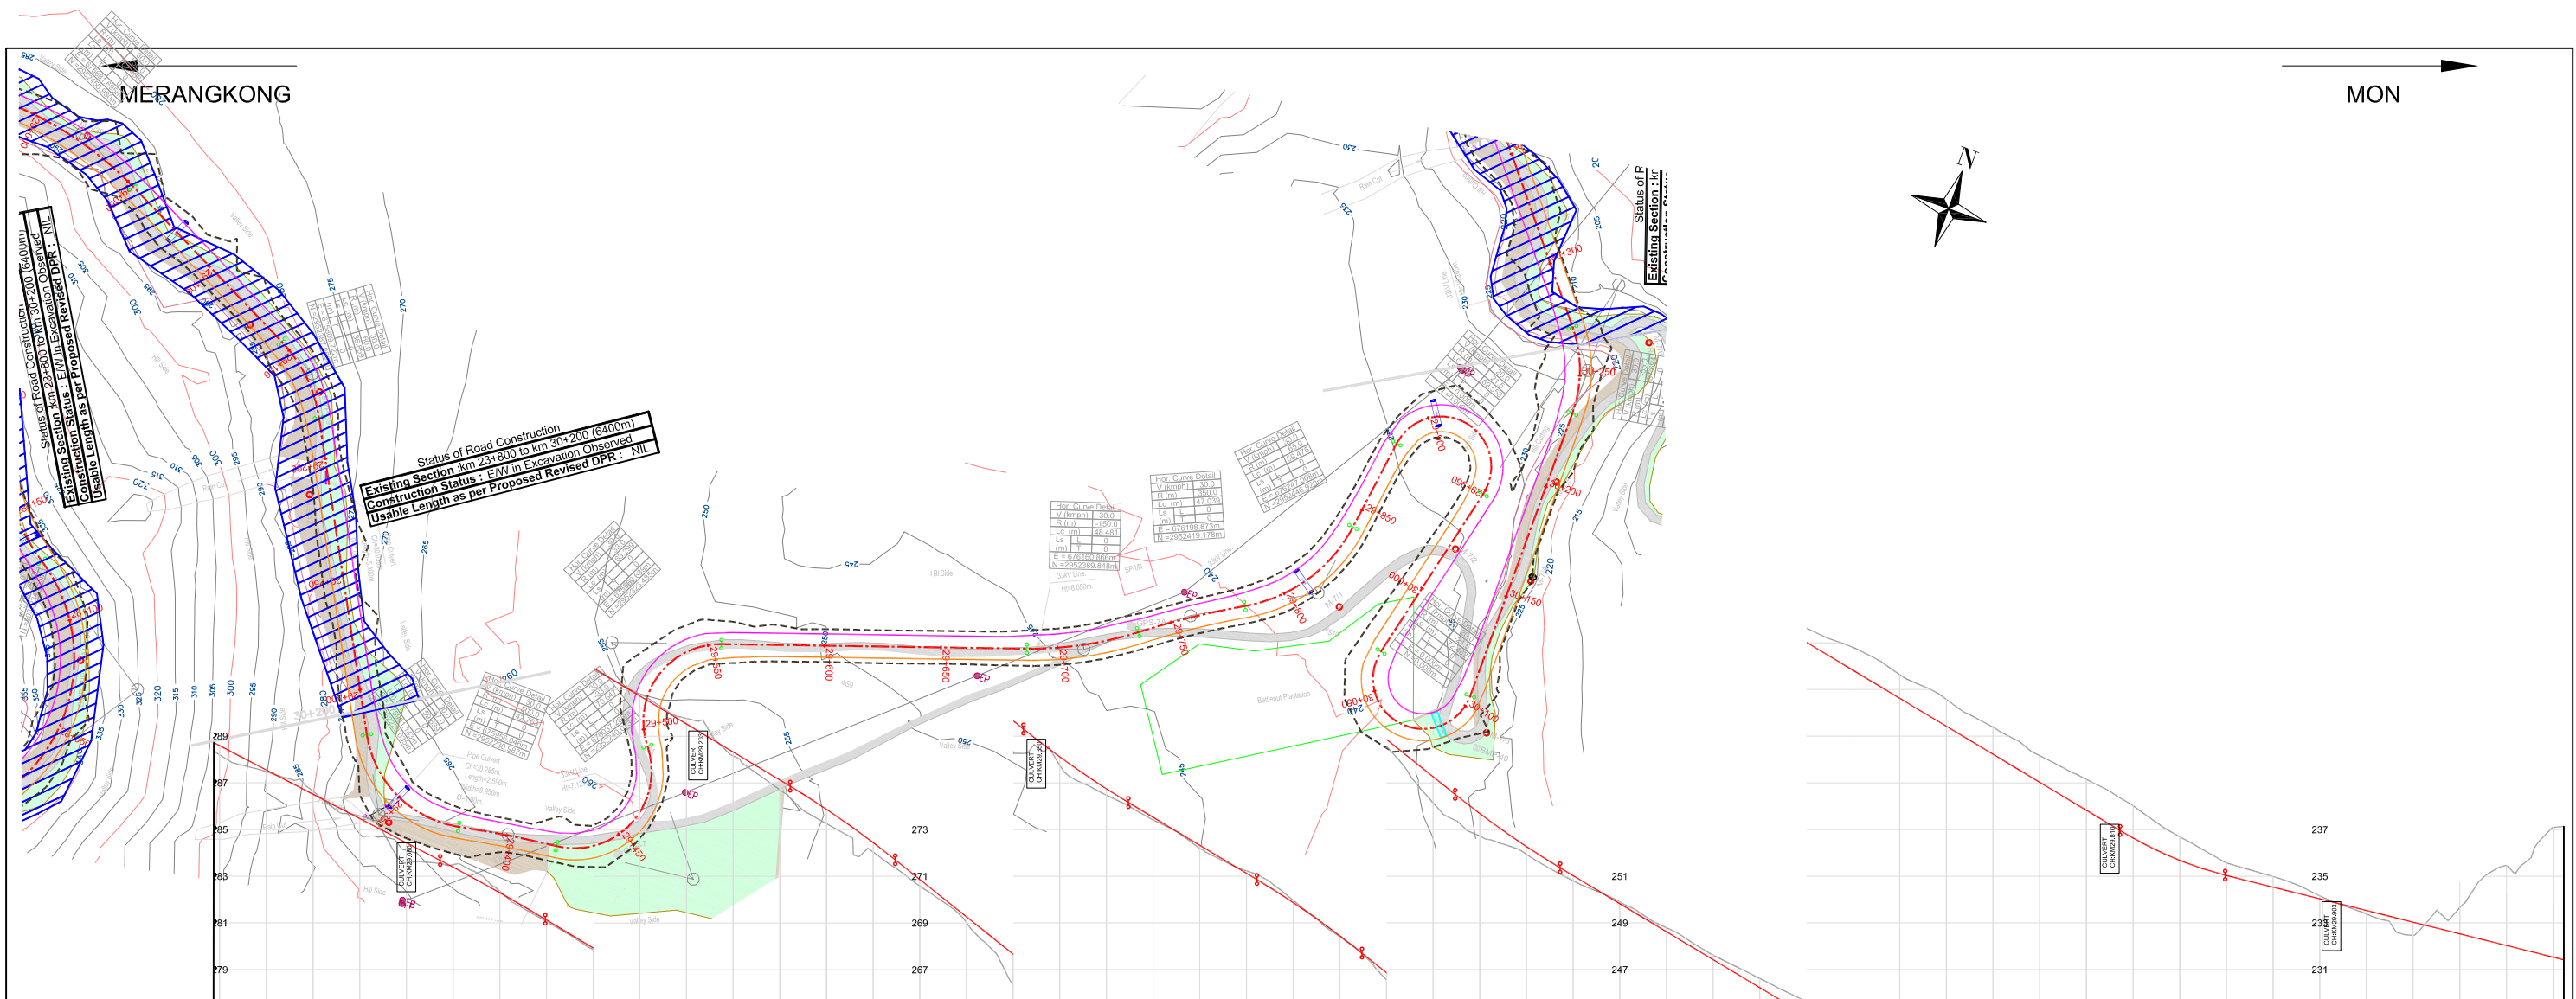

| |
|---|
| PROPOSED LEVEL (FRL) | 288.590 | 287.550 | 286.510 | 285.470 | 284.430 | 283.388 | 282.293 | 281.126 | 279.926 | 278.726 | 277.526 | 276.326 | 275.126 | 273.872 | 272.445 | 270.865 | 269.265 | 267.665 |
|---|

MERANGKONG



MON

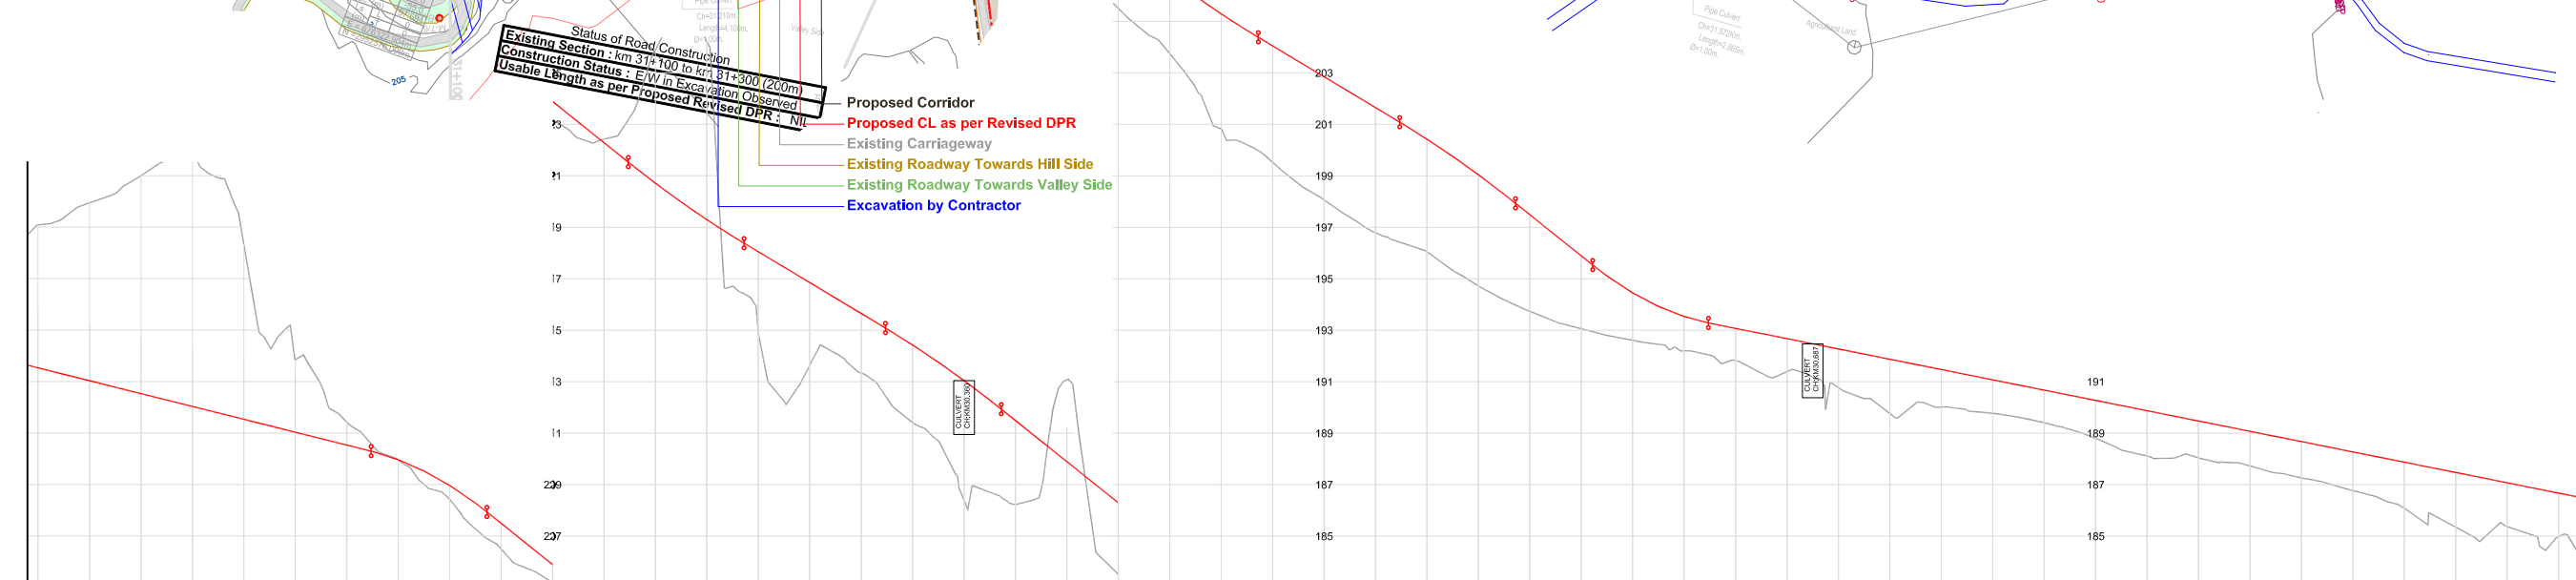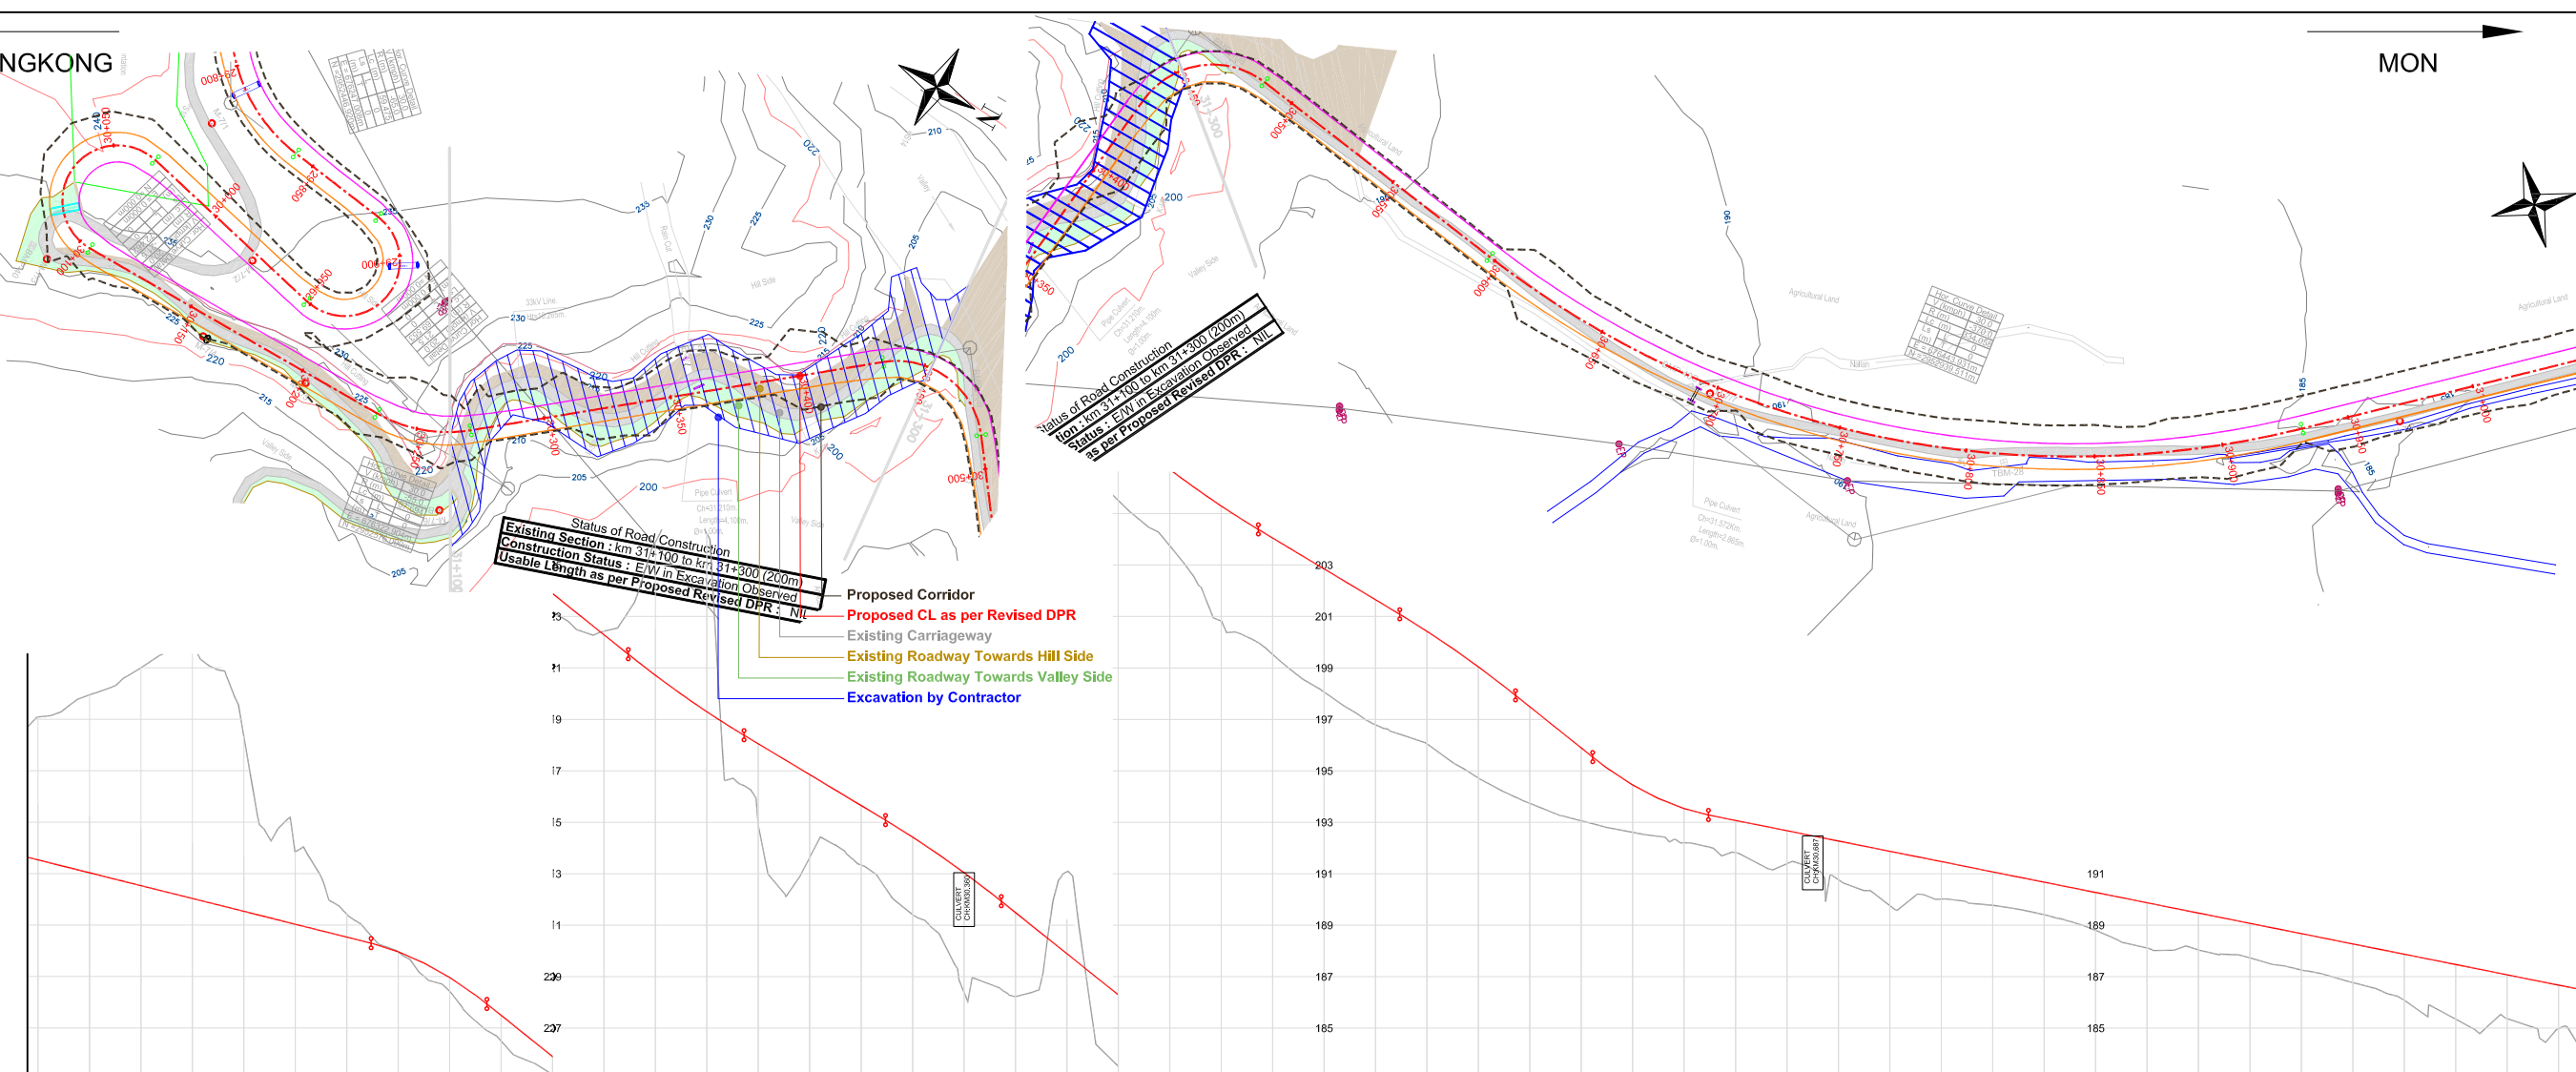

| |
|---|
| PROPOSED LEVEL (FRL) | 231.533 | 231.033 | 230.533 | 230.033 | 229.533 | 229.033 | 228.533 | 227.965 | 226.963 | 225.490 | 223.890 | 222.290 | 220.715 | 219.298 | 218.051 | 216.851 | 215.651 | 214.426 | 213.044 | 211.490 | 209.890 | 208.290 | 206.715 | 205.298 | 204.051 | 202.851 | 201.651 | 200.426 | 199.044 | 197.490 | 195.890 | 194.451 | 193.532 | 193.073 | 192.673 | 192.273 | 191.873 | 191.473 | 191.073 | 189.673 | 188.273 |
|---|

MERANGKONG

MON

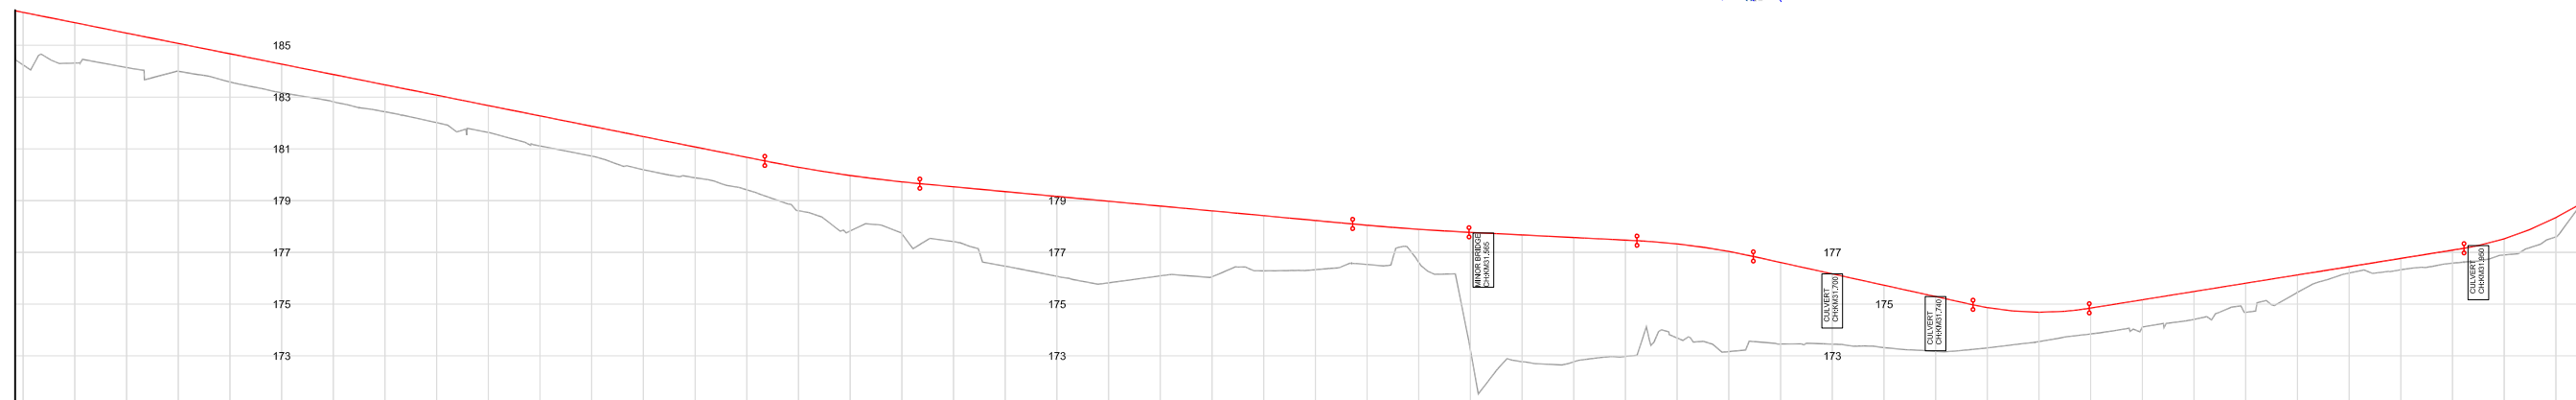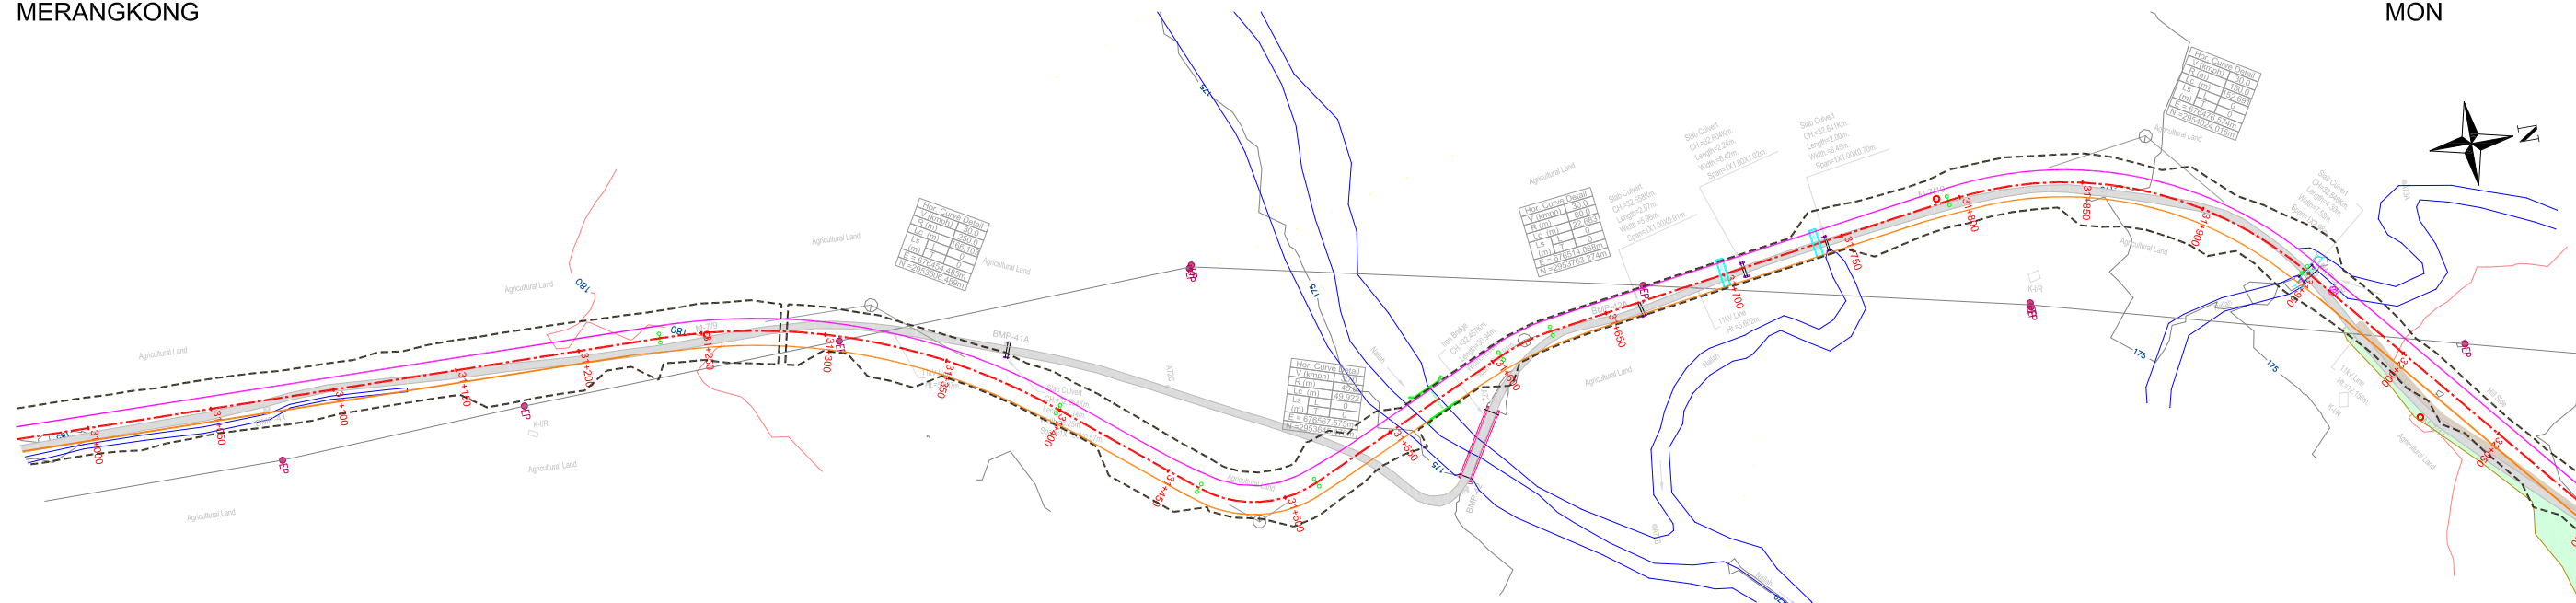

| |
|---|
| PROPOSED LEVEL (FRL)    | 184.241  | 184.316 | 184.143 | 183.998 | 185.073 | 184.673 | 184.273 | 183.873 | 183.473 | 183.073 | 182.673  | 182.273 | 181.873 | 181.473 | 181.073 | 180.673 | 180.288 | 179.970 | 179.724            | 179.533 | 179.347   | 179.161 | 178.975 | 178.789            | 178.603 | 178.417  | 178.231 | 178.047 | 177.891 | 177.772 | 177.672              | 177.572 | 177.472 | 177.327 | 177.034 | 176.611 | 176.171 | 175.731 | 175.291 | 174.864 | 174.686 | 174.846 | 175.166 | 175.486 | 175.806 | 176.126 | 176.446 | 176.766 | 177.086 | 177.524 | 178.344 | 179.500 |

| LEVEL DIFF. (FRL - NGL) | 2.031  | 1.557   | 1.330   | 1.075   | 1.089   | 1.107   | 1.054   | 1.041   | 1.062   | 1.039   | 1.163  | 1.153   | 1.282   | 1.192   | 1.255   | 1.680   | 2.142   | 2.008   | 2.119              | 2.882   | 3.087   | 3.153   | 2.898   | 2.550              | 2.131   | 1.901  | 1.515   | 1.272   | 4.548   | 4.899   | 4.802                | 4.496   | 3.635   | 3.868   | 3.153   | 2.718   | 2.410   | 2.113   | 1.555   | 1.134   | 1.000   | 1.052   | 1.079   | 1.124   | 0.674   | 0.247   | 0.439   | 0.504   | 0.626   | 0.747   | -1.035  |         |
| HORIZONTAL              | L=301.4m                                       |         |         |         |         |         |         |         |         |         | R=250.0m<br>L=166.1m   |         |         |         |         | L=65.1m |         |         | R=45.0m<br>L=49.9m |         | L=90.1m   |         |         | R=80.0m<br>L=22.7m |         | L=168.3m                                       |         |         |         |         | R=150.0m<br>L=152.7m |         |         
| SUPERELEVATION          | 2.50%  |         |         |         |         |         |         |         |         |         | 2.50%  |         |         |         |         | 2.50%   |         |         | 7.00%              |         | 2.50%   |         |         | 5.00%              |         | 2.50%  |         |         |         |         | 2.67%                |         |         
| CURVE WIDENING          | -2.50%   |         |         |         |         |         |         |         |         |         | -2.50%   |         |         |         |         | -2.50%  |         |         | -7.00%             |         | -2.50%  |         |         | -5.00%             |         | -2.50%   |         |         |         |         | -2.67%               |         |         
| VERTICAL SCHEMATIC      | L=60.0m  |         |         |         |         |         |         |         |         |         | G=-0.9<br>L=167.5m   |         |         |         |         | L=45.0m |         |         | G=-0.5<br>L=65.0m  |         | L=45.0m   |         |         | G=2.2<br>L=85.0m   |         | L=45.0m  |         |         |         |         | G=1.6<br>L=145.0m    |         |         
| WIDENING/IMP PROPOSAL   | Concentric Widening with Geometric Improvement |         |         |         |         |         |         |         |         |         | Widening on Right Side (Valley) with Geometric Improvement<br>BC = 30mm, DBM = 50MM, WMM = 250mm, GSB = 150mm, SG = 500mm ( CBR > 8% @ 97% @ MDD ) |         |         |         |         |         |         |         |                    |         | Widening on Left Side (Hill) with Geometric Improvement |         |         |                    |         | Concentric Widening with Geometric Improvement |         |         
| CHAINAGE                | 31+000   | 31+020  | 31+040  | 31+060  | 31+080  | 31+100  | 31+120  | 31+140  | 31+160  | 31+180  | 31+200   | 31+220  | 31+240  | 31+260  | 31+280  | 31+300  | 31+320  | 31+340  | 31+360             | 31+380  | 31+400  | 31+420  | 31+440  | 31+460             | 31+480  | 31+500   | 31+520  | 31+540  | 31+560  | 31+580  | 31+600               | 31+620  | 31+640  | 31+660  | 31+680  | 31+700  | 31+720  | 31+740  | 31+760  | 31+780  | 31+800  | 31+820  | 31+840  | 31+860  | 31+880  | 31+900  | 31+920  | 31+940  | 31+960  | 31+980  | 32+000  |         |

Notes :  
1) All Levels are in m unless otherwise indicated.



|          |           |                 |            |          |       |           |                 |
|----------|-----------|-----------------|------------|----------|-------|-----------|-----------------|
| R0       | Sep. 2017 | Tender Drawings | NKM / RJ   | DR       | DR    | NKS & SKB | Tapas Mukherjee |
| Revision | Date      | Stage / Report  | Topography | Designed | Drawn | Checked   | Approved        |

Client : Ministry of Road Transport & Highways (Government of India)

Consultant : RITES LIMITED, RITES BHAWAN, Plot No. 1, Sector-29, Gurgaon-122001

Project : Preparation of Revised Detailed Project Report and Verification of Executed Quantities/Items for Widening to 2 Lane of Merangkong-Tamlu-Mon Road, Changtongya-Longleng Road, Chakabama-Zunhebot Road & Pftusero-Phek Road under Phase 'A' of SARDP-NE in the State of Nagaland


Scale : Horizontal 1:50, 1:75, 1:100; Vertical 1:5, 1:7.5, 1:10

Title : ALIGNMENT PLAN & PROFILE : MERANGKONG TAMLU MON ROAD

Page No. : MTM-32


MERANGKONG

MON

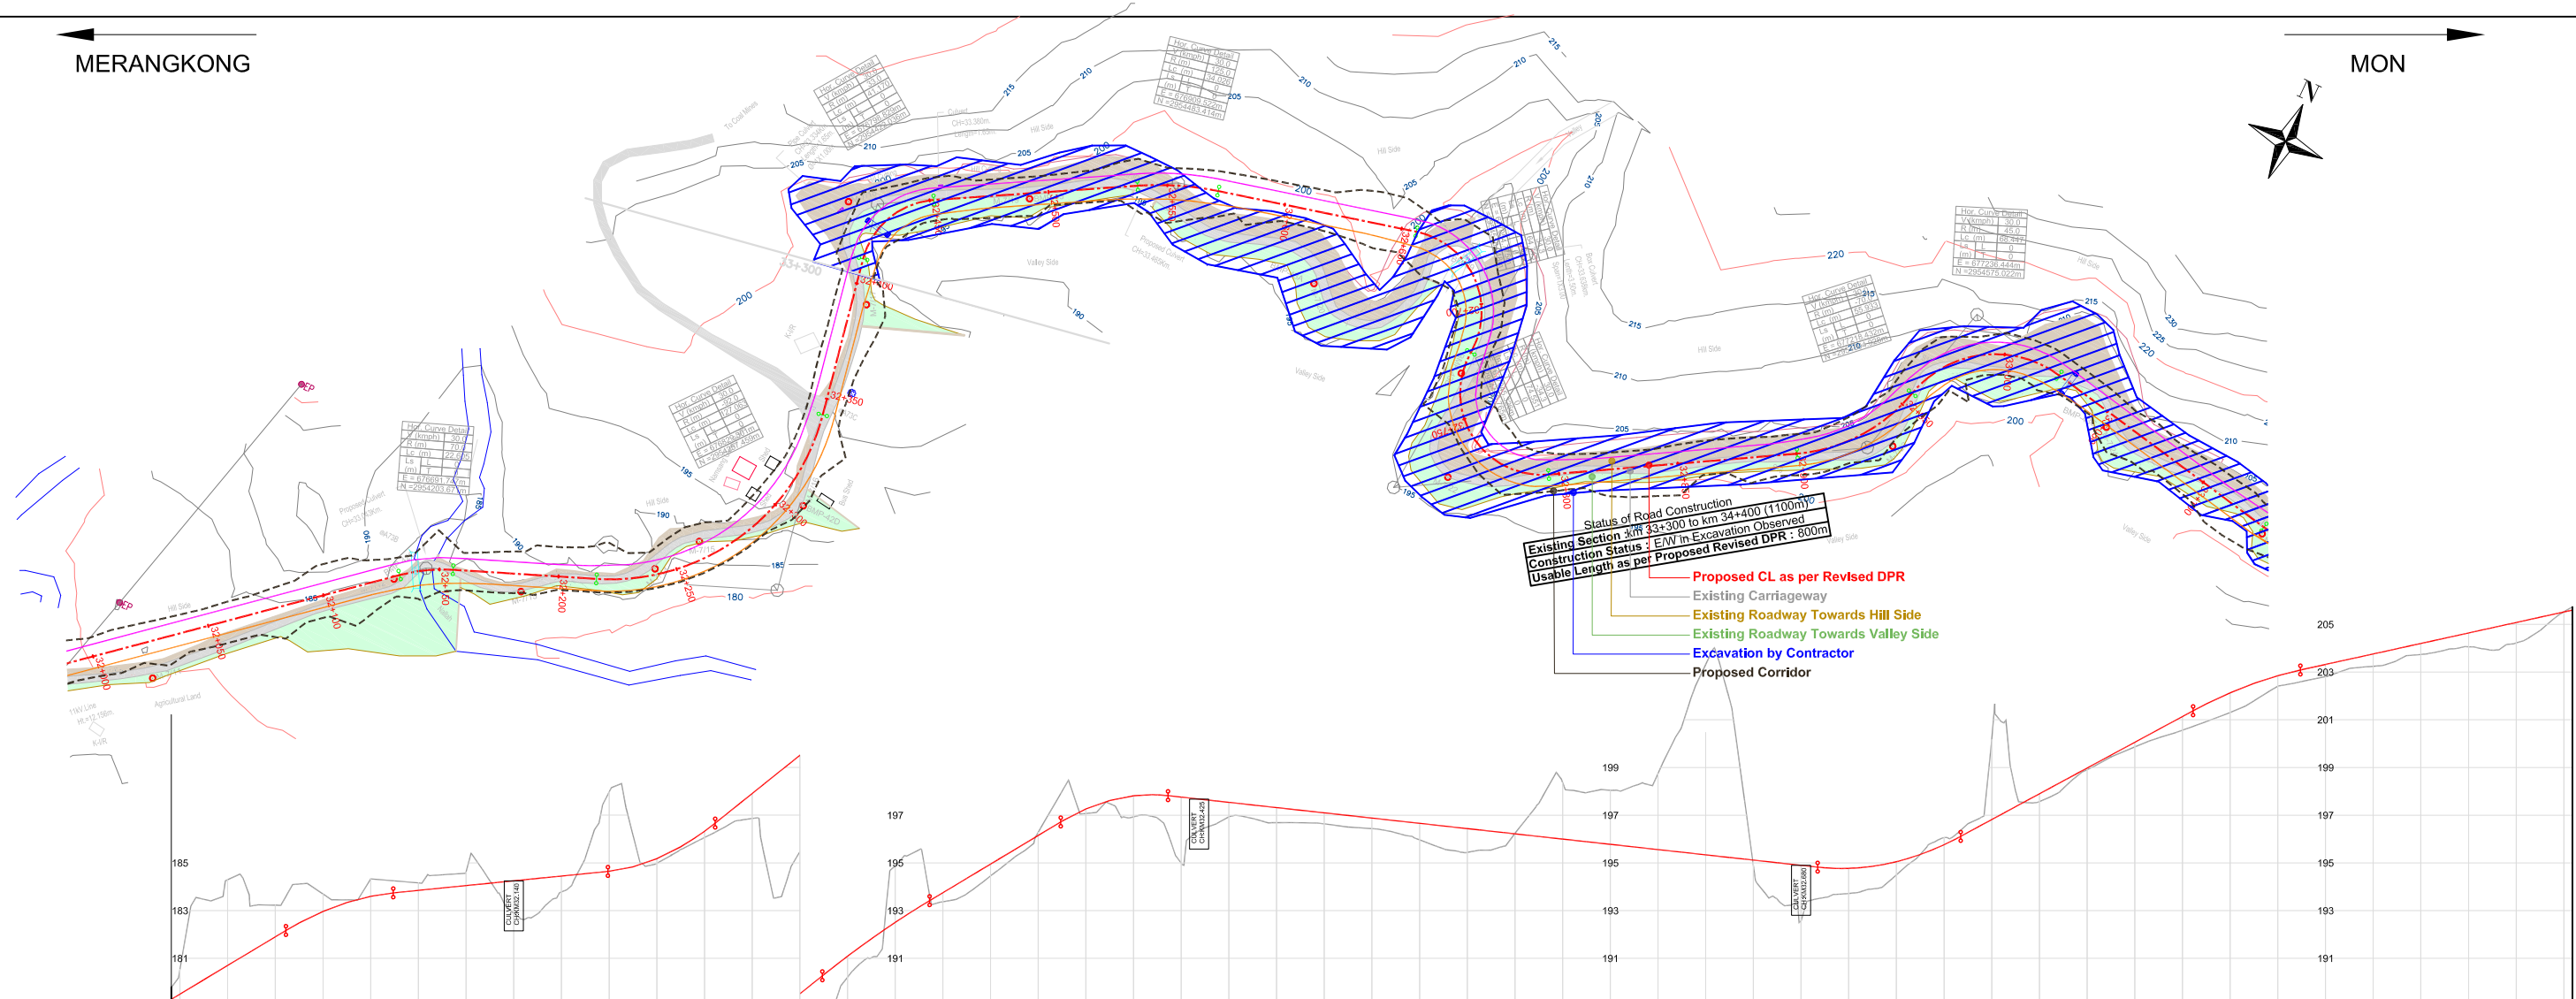

Status of Road Construction  
 Existing Section 3km 33+300 to km 34+400 (1100m)  
 Construction Status : E/W in Excavation Observed  
 Usable Length as per Proposed Revised DPR : 800m

Proposed CL as per Revised DPR  
 Existing Carriageway  
 Existing Roadway Towards Hill Side  
 Existing Roadway Towards Valley Side  
 Excavation by Contractor  
 Proposed Corridor

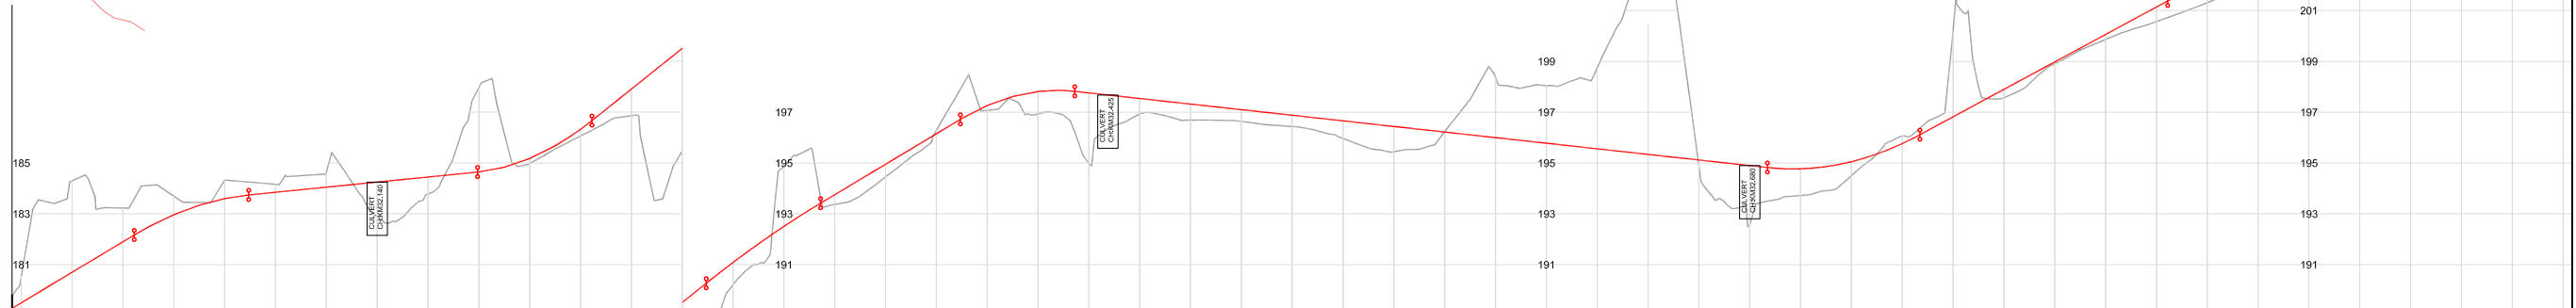

| |
|---|
| PROPOSED LEVEL (FRL)    | 179.500   | 180.700 | 181.900            | 182.966 | 183.598 | 183.848 | 184.048             | 184.246 | 184.448 | 184.648 | 185.176            | 186.326 | 187.911 | 189.511 | 191.086             | 192.504 | 193.750 | 194.950 | 196.150            | 197.262 | 197.814            | 197.759 | 197.539           | 197.319 | 197.099            | 196.879 | 196.659 | 196.439 | 196.219 | 
| EXISTING LEVEL (NGL)    | 180.536   | 184.292 | 185.228            | 183.695 | 184.328 | 184.162 | 184.618             | 182.894 | 183.781 | 187.972 | 184.981            | 186.063 | 186.861 | 185.470 | 190.205             | 194.868 | 193.370 | 194.453 | 196.282            | 197.071 | 196.930            | 194.994 | 196.934           | 196.688 | 196.636            | 196.439 | 196.439 | 196.240 | 196.219 | 196.369 | 198.045 | 192.565 | 194.899 | 198.744 | 196.165 | 196.060 | 197.568 | 198.908 | 199.863 | 200.564 | 201.306 | 202.131 | 202.409 | 202.811 | 203.241 | 203.738 | 204.060 | 204.221 | 205.080 | 205.532 | 205.520 | |
| LEVEL DIFF. (FRL - NGL) | -1.035  | -3.591  | -1.327             | -0.730  | -0.730  | -0.313  | -0.570              | 1.355   | 0.667   | -3.324  | 0.195              | 0.263   | 1.049   | 4.040   | 0.882               | -2.365  | 0.381   | 0.497   | -0.131             | 0.191   | 0.884              | 2.766   | 0.606             | 0.632   | 0.464              | 0.441   | 0.695   | 0.998   | -0.020  | -2.369  | -2.266  | -3.185  | -7.978  | 0.214   | 2.335   | 1.054   | 0.552   | -0.296  | -3.348  | 0.329   | 0.069   | 0.193   | 0.572   | 0.825   | 0.439   | 0.509   | 0.518   | 0.462   | 0.579   | 0.859   | -0.013  | |
| HORIZONTAL              | L=185.2m  |         | R=70.0m<br>L=22.6m |         | L=60.3m |         | R=92.0m<br>L=127.1m |         | L=67.6m |         | R=33.0m<br>L=41.2m |         | L=85.7m |         | R=125.0m<br>L=34.0m |         | L=84.8m |         | R=34.3m<br>L=64.7m |         | R=34.3m<br>L=74.6m |         | L=104.6m          |         | R=70.0m<br>L=55.9m |         | L=68.4m | |
| SUPERELEVATION          | 2.50%   |         | 5.71%              |         | 2.50%   |         | 4.35%               |         | 2.50%   |         | 7.00%              |         | 2.50%   |         | 3.20%               |         | 2.50%   |         | 7.00%              |         | 7.00%              |         | 2.50%             |         | 5.71%              |         | 7.00%   | |
| CURVE WIDENING          | 5.9   |         | 5.9                |         | 5.9     |         | 5.9                 |         | 5.9     |         | 6.5                |         | 6.5     |         | 6.5                 |         | 6.5     |         | 6.5                |         | 6.5                |         | 6.5               |         | 5.9                |         | 6.2     | |
| VERTICAL SCHEMATIC      | G=6.0<br>L=55.0m  |         | G=1.0<br>L=90.0m   |         | L=45.0m |         | G=8.0<br>L=45.0m    |         | L=45.0m |         | G=6.0<br>L=55.0m   |         | L=45.0m |         | G=-1.1<br>L=272.5m  |         | L=60.0m |         | L=97.5m<br>G=5.4   |         | L=45.0m            |         | G=2.2<br>L=140.0m | |
| WIDENING/IMP PROPOSAL   | Widening on Left Side (Hill) with Geometric Improvement<br>BC = 30mm, DBM = 50MM, WMM = 250mm, GSB = 150mm, SG = 500mm ( CBR > 8% @ 97% @ MDD ) | |
| CHAINAGE                | 32+000  | 32+020  | 32+040             | 32+060  | 32+080  | 32+100  | 32+120              | 32+140  | 32+160  | 32+180  | 32+200             | 32+220  | 32+240  | 32+260  | 32+280              | 32+300  | 32+320  | 32+340  | 32+360             | 32+380  | 32+400             | 32+420  | 32+440            | 32+460  | 32+480             | 32+500  | 32+520  | 32+540  | 32+560  | 32+580  | 32+600  | 32+620  | 32+640  | 32+660  | 32+680  | 32+700  | 32+720  | 32+740  | 32+760  | 32+780  | 32+800  | 32+820  | 32+840  | 32+860  | 32+880  | 32+900  | 32+920  | 32+940  | 32+960  | 32+980  | 33+000  | |

Notes :  
 1) All Levels are in m unless otherwise indicated.

|                         |                                   |
|-------------------------|-----------------------------------|
| Proposed CL :           | Existing Road :                   |
| Proposed CW :           | Existing Hill :                   |
| Contours 20m Interval : | Existing Valley :                 |
| Contours 5m Interval :  | Existing Hill Cutting Line :      |
| Proposed Major Bridge : | Existing Hill Toe Line :          |
| Proposed Minor Bridge : | Existing Valley Line :            |
| Proposed Pipe Culvert : | Important Buildings :             |
| Proposed Slab Culvert : | Other Buildings/Huts/Tile house : |
| Proposed Box Culvert :  |                                   |

|          |           |                 |            |          |       |           |                 |
|----------|-----------|-----------------|------------|----------|-------|-----------|-----------------|
| R0       | Sep. 2017 | Tender Drawings | NKM / RJ   | DR       | DR    | NKS & SKB | Tapas Mukherjee |
| Revision | Date      | Stage / Report  | Topography | Designed | Drawn | Checked   | Approved        |

Client : Ministry of Road Transport & Highways (Government of India)

Consultant : RITES LIMITED, RITES BHAWAN, Plot No. 1, Sector- 29, Gurgaon-122001

Project : Preparation of Revised Detailed Project Report and Verification of Executed Quantities/Items for Widening to 2 Lane of Merangkong-Tamlu-Mon Road, Changtongya-Longleng Road, Chakabama-Zunheboto Road & Pftusero-Phek Road under Phase 'A' of SARDP-NE in the State of Nagaland



Scale : Horizontal 1:50, 1:75, 1:100; Vertical 1:5, 1:7.5, 1:10

Title : ALIGNMENT PLAN & PROFILE : MERANGKONG TAMLU MON ROAD

Page No. : MTM - 33

MERANGKONG

MON

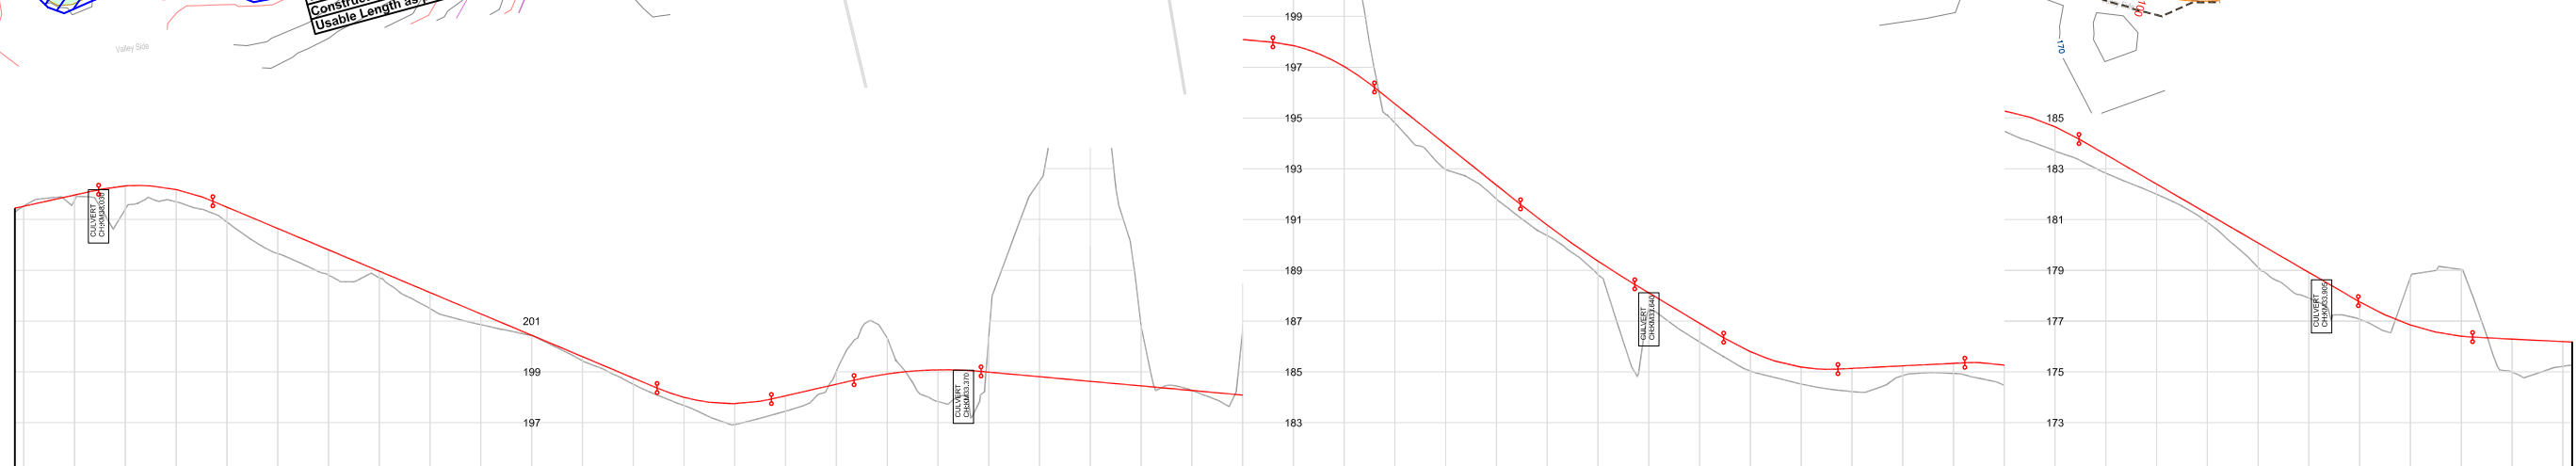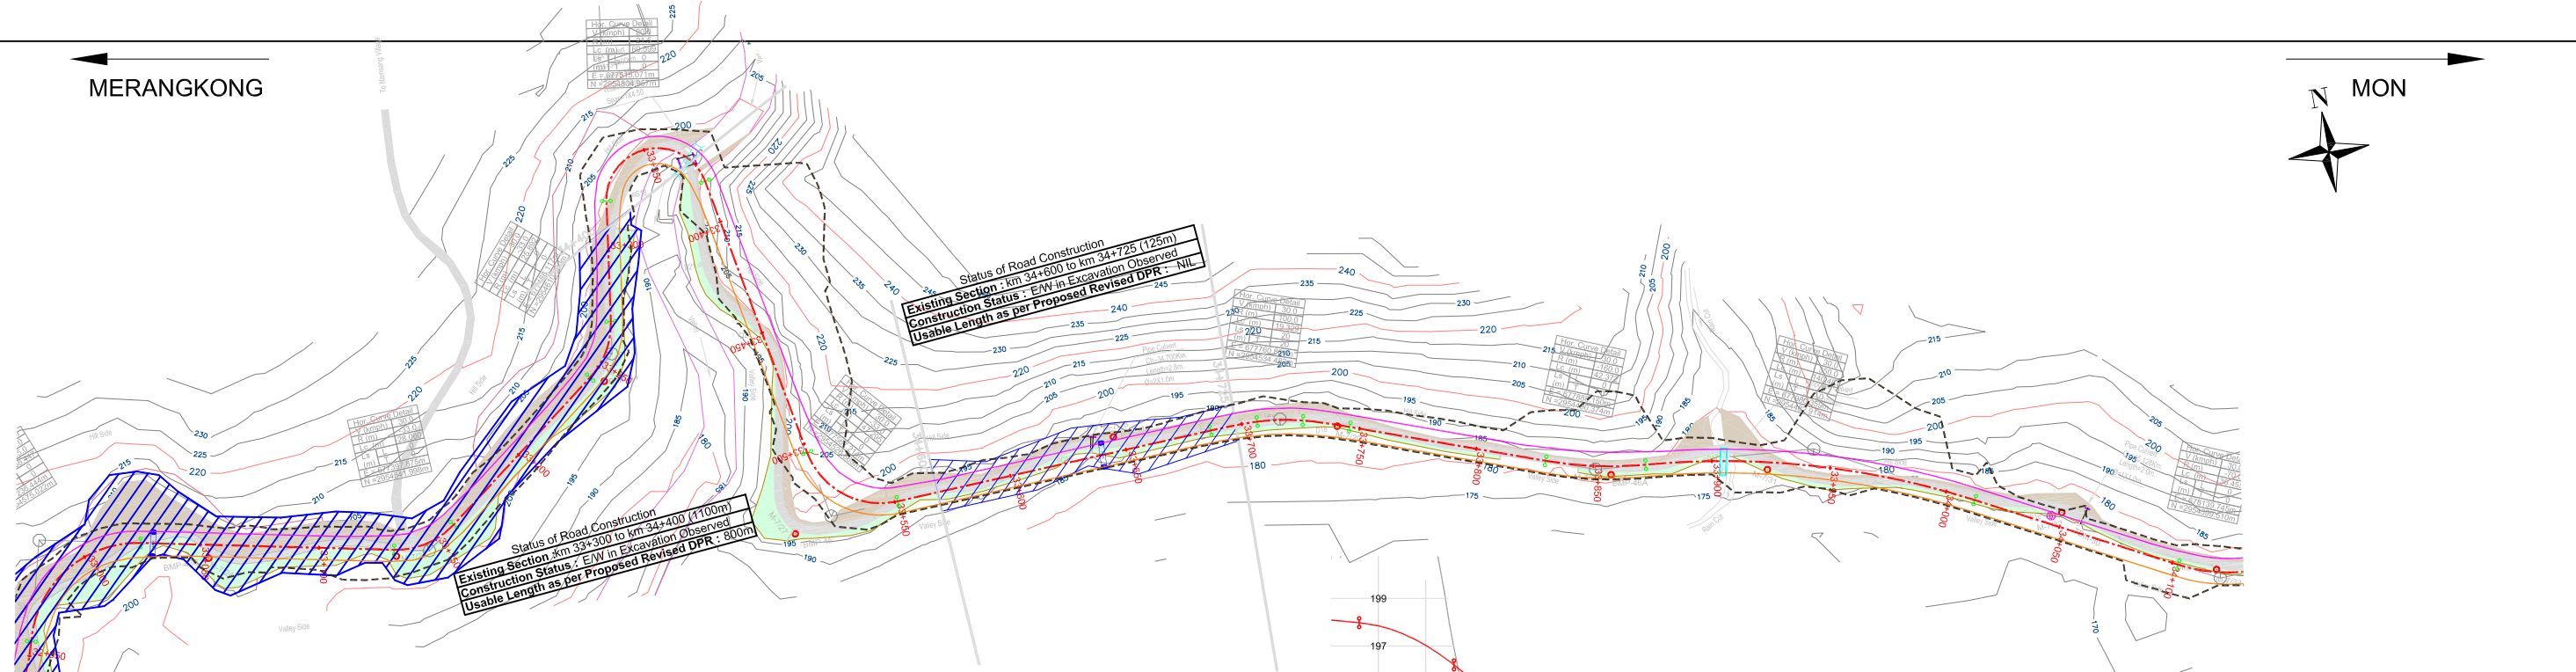

| |
|---|
| PROPOSED LEVEL (FRL)    | 205.520   | 205.532 | 205.560            | 205.660 | 206.176  | 205.484 | 204.643            | 203.803 | 202.962 | 202.122 | 201.281            | 200.440 | 199.600 | 198.759 | 198.000            | 197.752 | 198.059  | 198.514 | 198.916            | 199.078 | 198.989  | 198.809 | 198.628             | 198.448 | 198.267 | 198.086 | 197.848            | 197.028 | 195.554  | 193.954 | 192.354              | 190.779 | 189.362              | 188.115 | 186.915 | 185.795 | 185.189 | 184.224 | 185.138 | 185.238 | 185.338 | 185.269 | 184.654 | 183.556 | 182.396 | 181.236 | 180.076 | 178.916 | 177.756 | 176.845 | 176.404 | 176.292 | 175.192 |  |  |  |
| EXISTING LEVEL (NGL)    | 205.532   | 205.749 | 205.404            | 205.696 | 206.176  | 204.897 | 203.656            | 202.810 | 202.701 | 201.492 | 200.859            | 200.430 | 199.435 | 198.514 | 197.676            | 196.928 | 197.452  | 199.019 | 200.340            | 197.830 | 200.382  | 206.502 | 212.273             | 200.827 | 198.270 | 200.611 | 205.639            | 201.399 | 194.804  | 192.968 | 191.807              | 190.368 | 188.820              | 187.480 | 186.181 | 185.039 | 184.522 | 184.224 | 184.851 | 184.938 | 184.474 | 183.699 | 182.825 | 181.997 | 180.694 | 179.111 | 177.907 | 177.068 | 176.729 | 179.034 | 174.991 | 175.220 |         |  |  |  |
| LEVEL DIFF. (FRL - NGL) | -0.013  | 0.211   | 0.916              | 0.480   | 0.588    | 0.985   | 0.992              | 0.262   | 0.630   | 0.423   | 0.011              | 0.165   | 0.246   | 0.324   | 0.825              | 0.607   | -0.505   | -1.425  | 1.248              | -1.392  | -7.694   | -13.645 | -2.379              | -0.003  | -2.524  | -7.590  | -4.371             | 0.751   | 0.987  | 0.548   | 0.411                | 0.533   | 0.635                | 0.734   | 0.757   | 0.666   | 0.913   | 0.386   | 0.399   | 0.795   | 0.955   | 0.731   | 0.399   | 0.342   | 0.966   | 1.009   | 0.689   | -1.884  | -2.630  | 1.302   | 0.972   |         |         |  |  |  |
| HORIZONTAL              | .0m   |         | 4m                 |         | L=107.0m |         | R=33.0m<br>L=28.1m |         | L=84.6m |         | R=33.0m<br>L=25.9m |         | L=50.8m |         | R=21.5m<br>L=60.6m |         | L=122.2m |         | R=33.0m<br>L=47.3m |         | L=135.4m |         | R=100.0m<br>L=19.3m |         | L=20.0m |         | L=20.0m            |         | L=83.8m  |         | R=-160.0m<br>L=42.4m |         | R=350.0m<br>L=140.5m |         |         
| SUPERELEVATION          | 0%  |         | 2.50%              |         | 7.00%    |         | 2.50%              |         | 7.00%   |         | 2.50%              |         | 7.00%   |         | 2.50%              |         | 7.00%    |         | 2.50%              |         | 7.00%    |         | 2.50%               |         | 4.00%   |         | 2.50%              |         | 2.50%  |         | 2.50%                |         | 2.50%                |         | 2.50%   |         | 2.50%   |         | 2.50%   |         | 2.50%   |         | 2.50%   |         | 2.50%   |         | 2.50%   |         | 2.50%   |         |         |         |         |  |  |  |
| CURVE WIDENING          |   |         |                    |         | 6.5      |         | 6.5                |         | 6.5     |         | 6.5                |         | 6.5     |         | 6.5                |         | 6.5      |         | 6.5                |         | 6.5      |         | 6.5                 |         | 5.8     |         | 5.8                |         | 5.8  |         | 5.8                  |         | 5.8                  |         | 5.8     |         | 5.8     |         | 5.8     |         | 5.8     |         | 5.8     |         | 5.8     |         | 5.8     |         | 5.8     |         |         |         |         |  |  |  |
| VERTICAL SCHEMATIC      | L=45.0m   |         | G=-4.2<br>L=174.9m |         | L=45.0m  |         | G=2.3<br>L=32.6m   |         | L=50.0m |         | G=-0.9<br>L=115.0m |         | L=40.0m |         | G=-8.0<br>L=57.5m  |         | L=45.0m  |         | G=-6.0<br>L=35.0m  |         | L=45.0m  |         | G=0.5<br>L=50.0m    |         | L=45.0m |         | G=-5.8<br>L=110.0m |         | L=45.0m  |         |                      
| WIDENING/IMP PROPOSAL   | Widening on Left Side (Hill) with Geometric Improvement |         |                    Widening on Right Side (Valley) with Geometric Improvement |         |                      
| CHAINAGE                | 33+000  | 33+020  | 33+040             | 33+060  | 33+080   | 33+100  | 33+120             | 33+140  | 33+160  | 33+180  | 33+200             | 33+220  | 33+240  | 33+260  | 33+280             | 33+300  | 33+320   | 33+340  | 33+360             | 33+380  | 33+400   | 33+420  | 33+440              | 33+460  | 33+480  | 33+500  | 33+520             | 33+540  | 33+560   | 33+580  | 33+600               | 33+620  | 33+640               | 33+660  | 33+680  | 33+700  | 33+720  | 33+740  | 33+760  | 33+780  | 33+800  | 33+820  | 33+840  | 33+860  | 33+880  | 33+900  | 33+920  | 33+940  | 33+960  | 33+980  | 34+000  |         |         |  |  |  |

Notes :  
1) All Levels are in m unless otherwise indicated.

|                         |                                   |
|-------------------------|-----------------------------------|
| Proposed CL :           | Existing Road :                   |
| Proposed CW :           | Existing Hill :                   |
| Contours 20m Interval : | Existing Valley :                 |
| Contours 5m Interval :  | Existing Hill Cutting Line :      |
| Proposed Major Bridge : | Existing Hill Toe Line :          |
| Proposed Minor Bridge : | Existing Valley Line :            |
| Proposed Pipe Culvert : | Important Buildings :             |
| Proposed Slab Culvert : | Other Buildings/Huts/Tile house : |
| Proposed Box Culvert :  |                                   |

|          |           |                 |            |          |       |           |                 |
|----------|-----------|-----------------|------------|----------|-------|-----------|-----------------|
| R0       | Sep. 2017 | Tender Drawings | NKM / RJ   | DR       | DR    | NKS & SKB | Tapas Mukherjee |
| Revision | Date      | Stage / Report  | Topography | Designed | Drawn | Checked   | Approved        |

Client : Ministry of Road Transport & Highways (Government of India)

Consultant : RITES LIMITED, RITES BHAWAN, Plot No. 1, Sector- 29, Gurgaon-122001



Project : Preparation of Revised Detailed Project Report and Verification of Executed Quantities/Items for Widening to 2 Lane of Merangkong-Tamlu-Mon Road, Changtongya-Longleng Road, Chakabama-Zunhebot Road & Pftusero-Phek Road under Phase 'A' of SARDP-NE in the State of Nagaland

Scale : Horizontal 1:50, 1:75, 1:100; Vertical 1:5, 1:7.5, 1:10

Title : ALIGNMENT PLAN & PROFILE : MERANGKONG TAMLU MON ROAD

Page No. : MTM-34



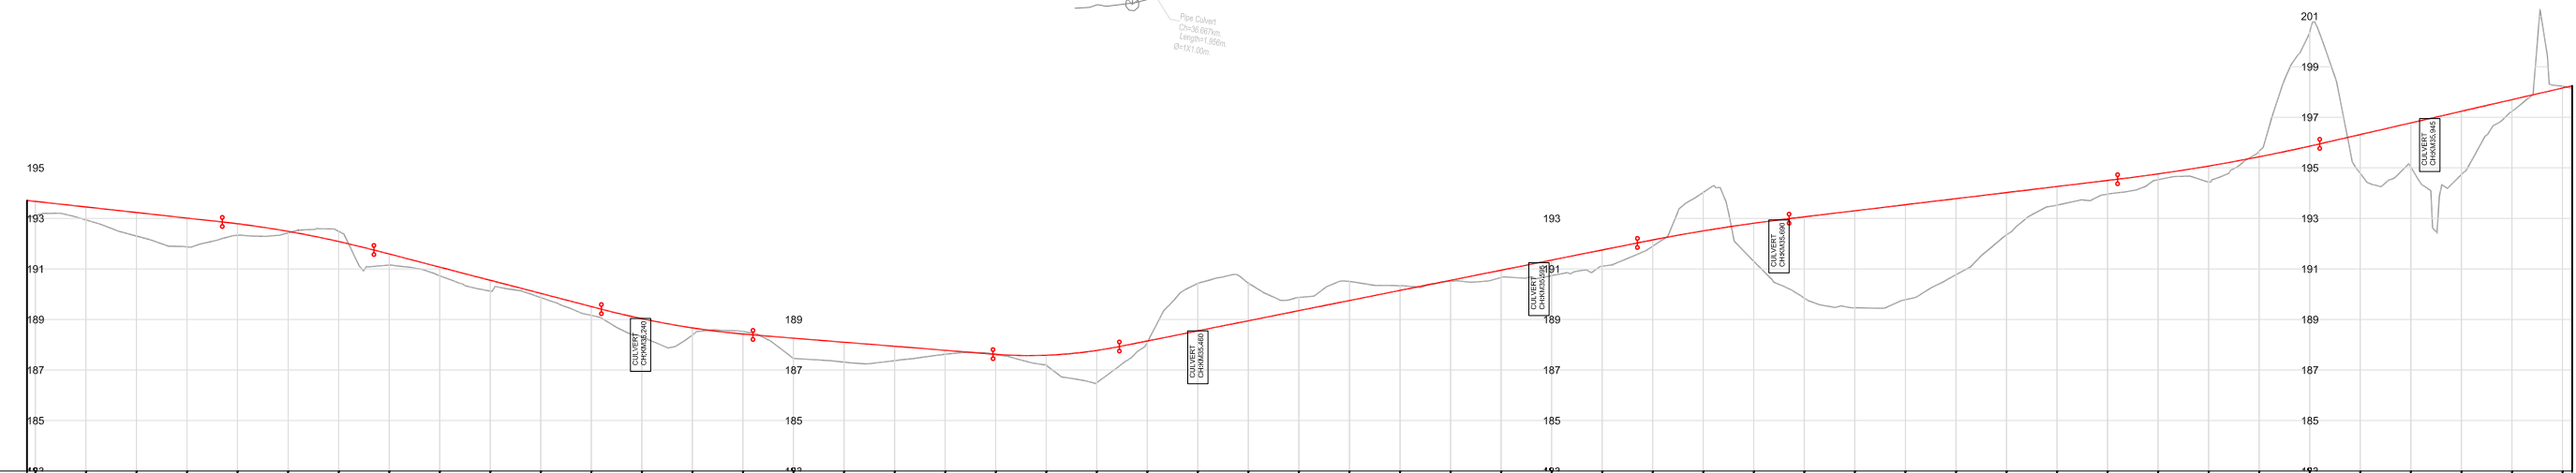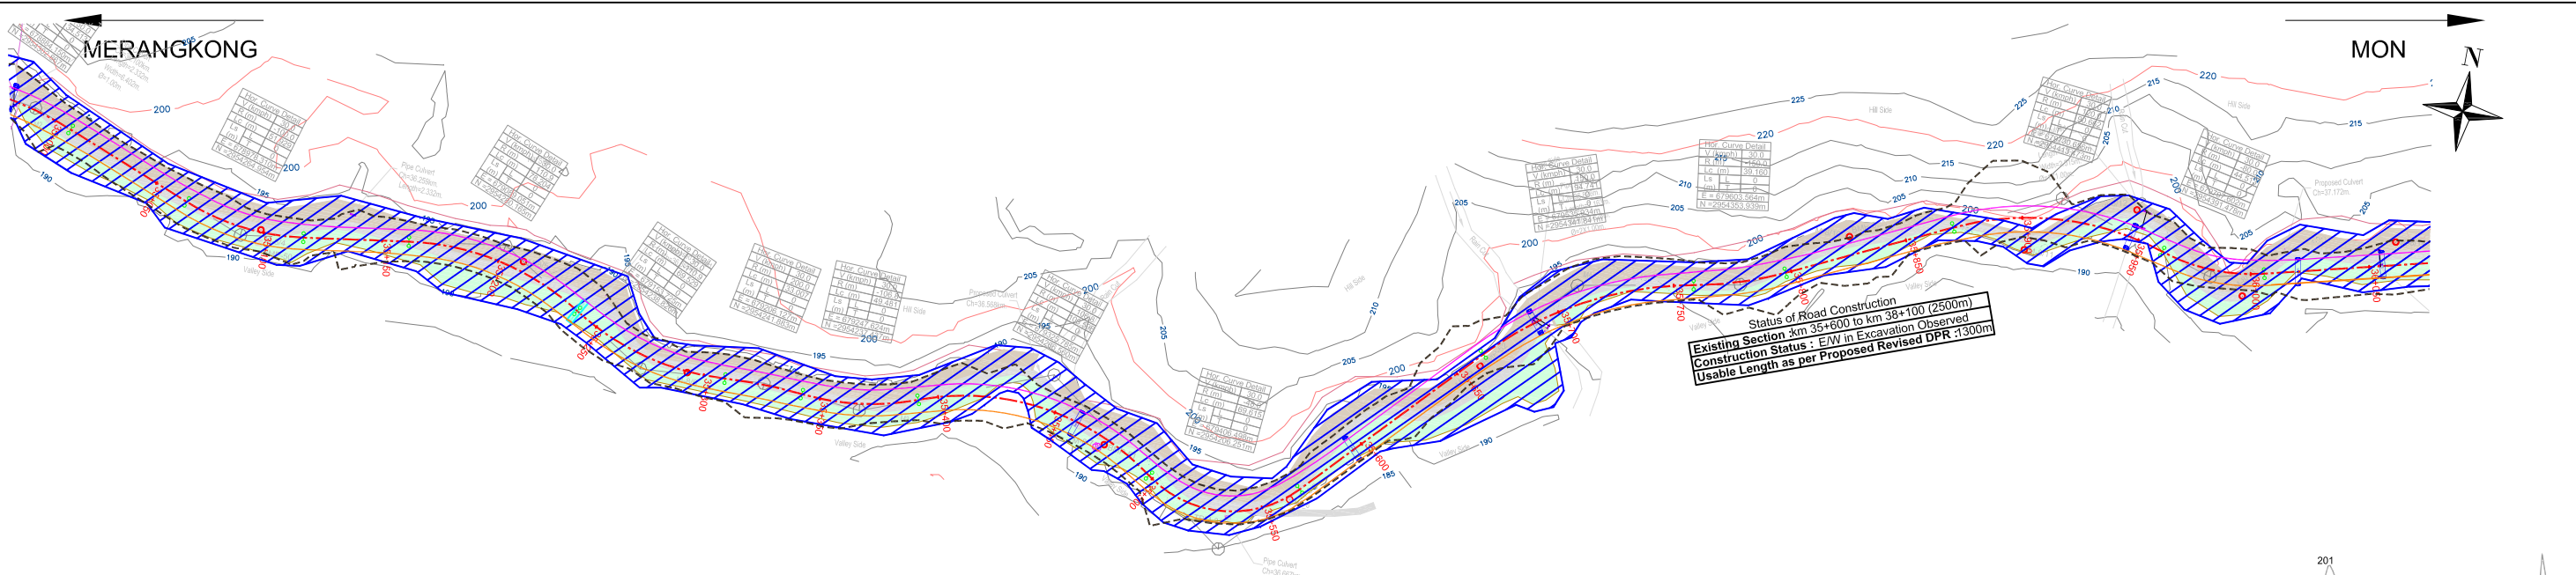

| |
|---|
| PROPOSED LEVEL (FRL)    | 193.871  | 193.451 | 193.231  | 193.011 | 192.787  | 192.486 | 192.086  | 191.591 | 191.071  | 190.551 | 190.031  | 189.511 | 189.029  | 188.665 | 188.422  | 188.259 | 188.099  | 187.939 | 187.779  | 187.620 | 187.563  | 187.403 | 187.243 | 187.083 | 170.123 | 170.000 |
| EXISTING LEVEL (NGL)    | 193.110  | 192.936 | 192.301  | 191.872 | 192.329  | 192.425 | 192.468  | 191.154 | 190.727  | 190.123 | 189.864  | 189.159 | 188.311  | 188.388 | 188.522  | 188.459 | 187.312  | 187.369 | 187.623  | 187.609 | 187.201  | 187.563 | 186.501 | 186.085 | 190.428 | 190.433 | 189.873 | 190.503 | 190.334 | 190.148 | 190.515 | 190.548 | 190.659 | 190.948 | 190.733 | 191.348 | 191.106 | 191.748 | 191.899 | 192.146 | 194.027 | 192.503 | 191.300 | 192.807 | 189.842 | 193.060 | 189.463 | 193.300 | 189.781 | 193.540 | 190.771 | 193.780 | 192.345 | 194.020 | 193.523 | 194.260 | 193.958 | 194.500 | 194.527 | 194.758 | 194.440 | 195.069 | 195.663 | 195.436 | 200.374 | 194.780 | 196.317 | 195.032 | 196.777 | 194.735 | 197.237 | 197.235 | 197.697 | 198.228 | 198.157 | |
| LEVEL DIFF. (FRL - NGL) | 0.562  | 0.516   | 0.931    | 1.139   | 0.457    | 0.061   | -0.402   | 0.436   | 0.343    | 0.427   | 0.167    | 0.352   | 0.718    | 0.278   | -0.101   | 0.800   | 0.788    | 0.570   | 0.156    | 0.010   | 0.382    | 1.269   | 0.063   | -1.879  | -1.485  | -0.524  | -0.755  | -0.186  | 0.033   | 0.289   | 0.616   | 0.642   | 0.248   | -1.524  | 1.508   | 3.218   | 3.837   | 3.760   | 3.010   | 1.875   | 0.737   | 0.542   | 0.230   | 0.629   | -0.226  | -4.517  | 1.537   | 1.745   | 2.501   | 0.462   | -0.071  | |
| HORIZONTAL              | 0m   |         | R=100.0m |         | R=110.9m |         | R=110.9m |         | R=200.0m |         | R=106.8m |         | R=106.8m |         | R=48.0m  |         | R=150.0m |         | R=150.0m |         | R=120.0m |         | R=80.0m | |
|                         | L=57.6m  |         | L=51.9m  |         | L=44.4m  |         | L=78.2m  |         | L=69.5m  |         | L=33.0m  |         | L=49.5m  |         | L=106.6m |         | L=69.6m  |         | L=95.9m  |         | L=94.7m  |         | L=39.2m |         | L=73.0m |         | L=90.7m |         | L=44.5m | |
| SUPERELEVATION          | 7%   | 2.50%   | 4.00%    | 2.50%   | 3.61%    | 3.61%   | 2.50%    | 3.75%   | 3.75%    | 7.00%   | 2.50%    | 2.67%   | 2.67%    | 2.50%   | 3.33%    | 5.00%   | |
|                         | 7%   | -2.50%  | -4.00%   | -2.50%  | -3.61%   | -3.61%  | -2.50%   | -3.75%  | -3.75%   | -7.00%  | -2.50%   | -2.67%  | -2.67%   | -2.50%  | -3.33%   | -5.00%  | |
| CURVE WIDENING          | 5.9  |         | 5.6      |         | 5.6      |         | 5.6      |         | 5.6      |         | 6.2      |         | 5.6      |         | 5.6      |         | 5.6      |         | 5.6      | |
| VERTICAL SCHEMATIC      | L=60.0m  |         | L=90.0m  |         | L=60.0m  |         | G=-0.8   |         | L=50.0m  |         | G=2.0    |         | L=60.0m  |         | G=1.2    |         | L=80.0m  |         | G=2.3    | |
| WIDENING/IMP PROPOSAL   | Widening on Right Side (Valley) with Geometric Improvement<br>BC = 30mm , DBM = 50MM , WMM = 250mm , GSB = 150mm , SG = 500mm ( CBR > 8% @ 97% @ MDD ) | |
| CHAINAGE                | 35+000   | 35+020  | 35+040   | 35+060  | 35+080   | 35+100  | 35+120   | 35+140  | 35+160   | 35+180  | 35+200   | 35+220  | 35+240   | 35+260  | 35+280   | 35+300  | 35+320   | 35+340  | 35+360   | 35+380  | 35+400   | 35+420  | 35+440  | 35+460  | 35+480  | 35+500  | 35+520  | 35+540  | 35+560  | 35+580  | 35+600  | 35+620  | 35+640  | 35+660  | 35+680  | 35+700  | 35+720  | 35+740  | 35+760  | 35+780  | 35+800  | 35+820  | 35+840  | 35+860  | 35+880  | 35+900  | 35+920  | 35+940  | 35+960  | 35+980  | 36+000  | |

Notes :  
1) All Levels are in m unless otherwise indicated.

|                         |                                   |
|-------------------------|-----------------------------------|
| Proposed CL :           | Existing Road :                   |
| Proposed CW :           | Existing Hill :                   |
| Contours 20m Interval : | Existing Valley :                 |
| Contours 5m Interval :  | Existing Hill Cutting Line :      |
| Proposed Major Bridge : | Existing Hill Toe Line :          |
| Proposed Minor Bridge : | Existing Valley Line :            |
| Proposed Pipe Culvert : | Important Buildings :             |
| Proposed Slab Culvert : | Other Buildings/Huts/Tile house : |
| Proposed Box Culvert :  |                                   |

|          |           |                 |            |          |       |           |                 |
|----------|-----------|-----------------|------------|----------|-------|-----------|-----------------|
| R0       | Sep. 2017 | Tender Drawings | NKM / RJ   | DR       | DR    | NKS & SKB | Tapas Mukherjee |
| Revision | Date      | Stage / Report  | Topography | Designed | Drawn | Checked   | Approved        |

Client : Ministry of Road Transport & Highways (Government of India)


Consultant : RITES LIMITED, RITES BHAWAN, Plot No. 1, Sector- 29, Gurgaon-122001

Project : Preparation of Revised Detailed Project Report and Verification of Executed Quantities/Items for Widening to 2 Lane of Merangkong-Tamlu-MonRoad, Changtongya-LonglengRoad, Chakabama-Zunheboto Road & Pftusero-Phek Road under Phase 'A' of SARDP-NE in the State of Nagaland

Scale : Horizontal 1:50, 1:75, 1:100; Vertical 1:5, 1:7.5, 1:10

Title : ALIGNMENT PLAN & PROFILE : MERANGKONG TAMLU MON ROAD

Page No. : MTM-36

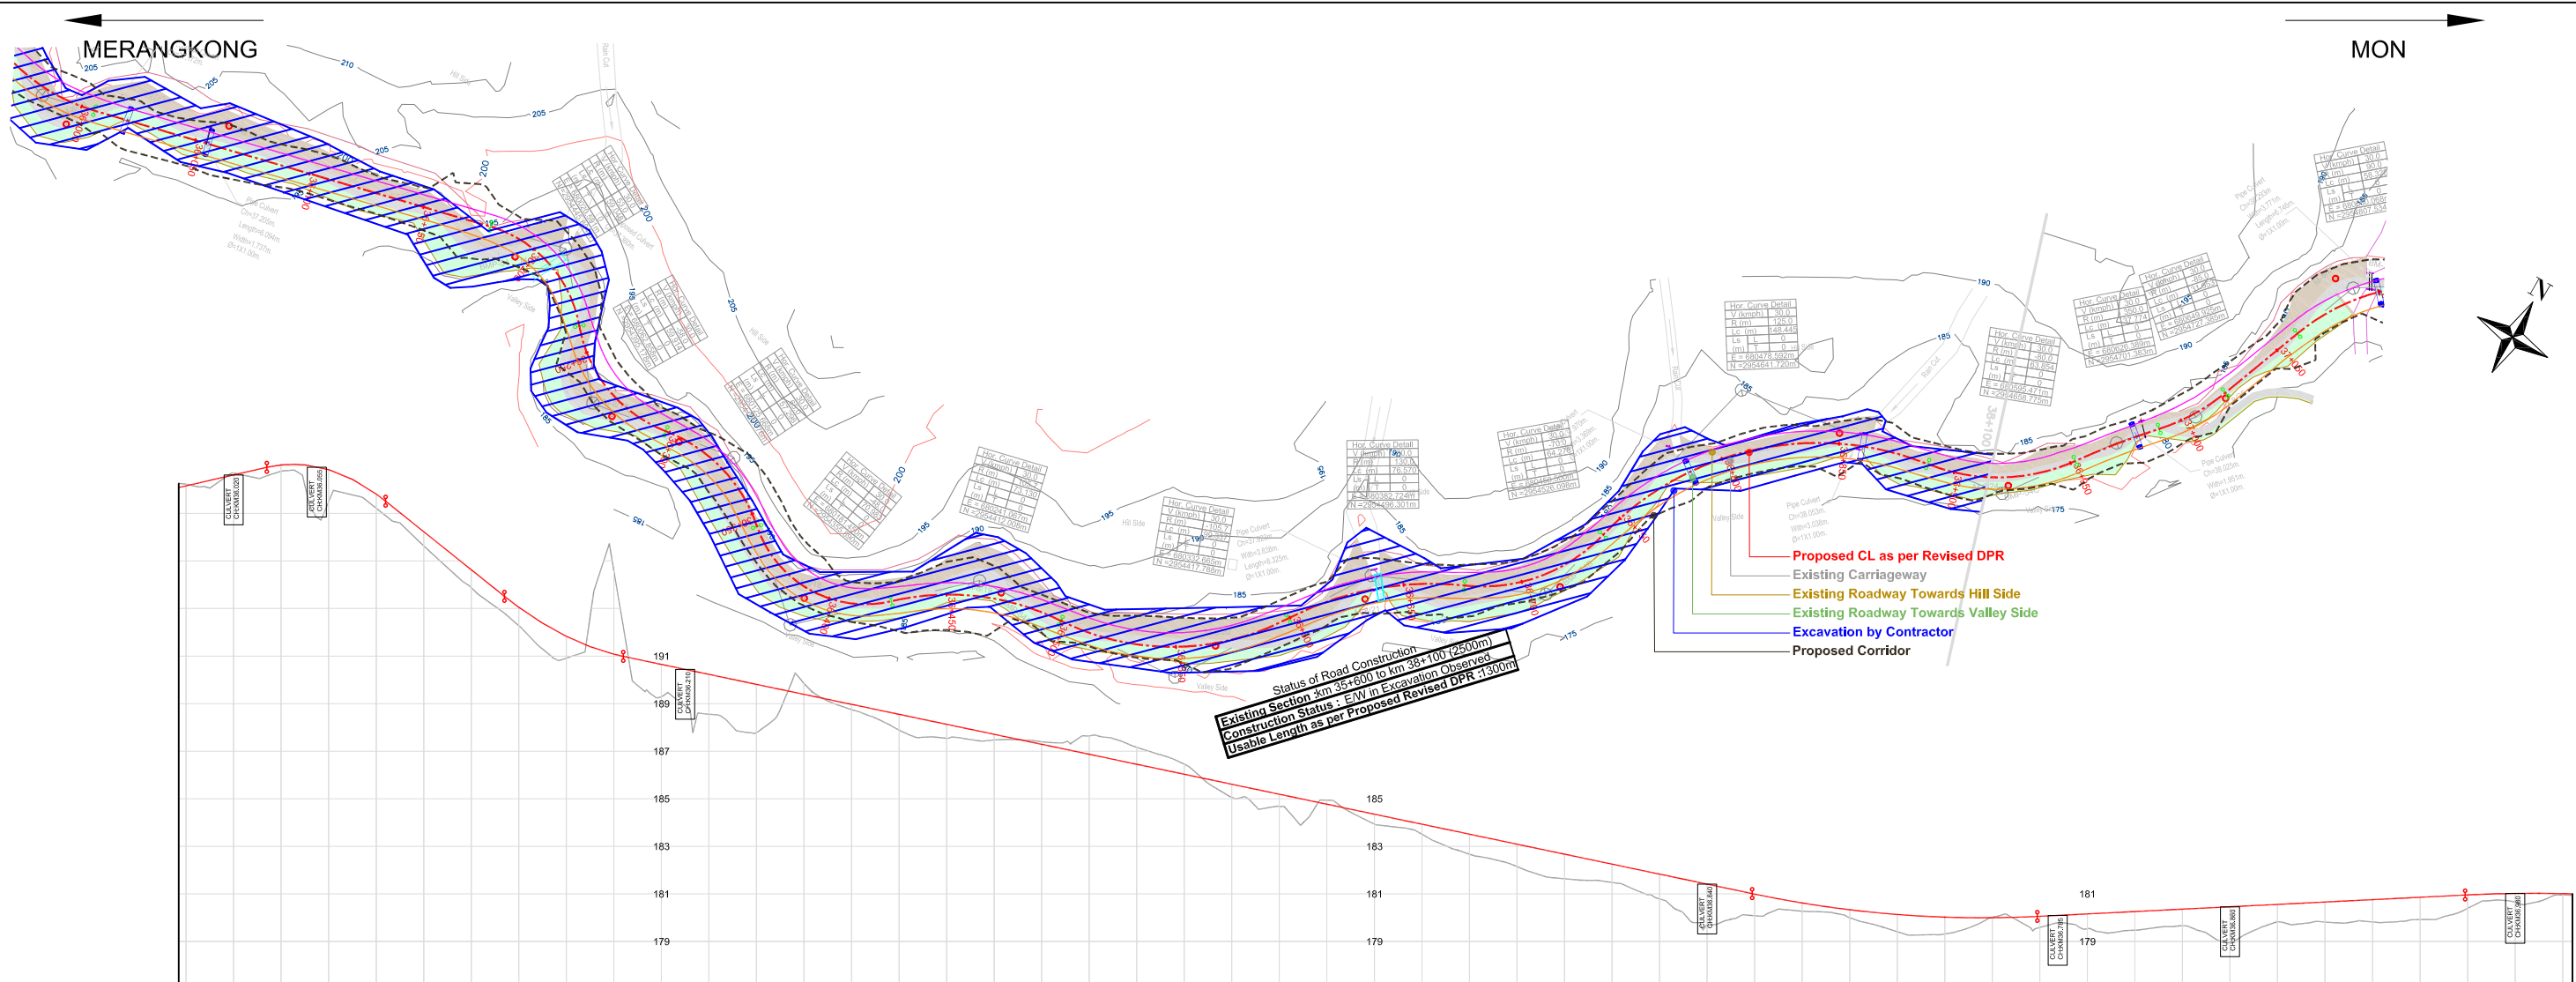

| |
|---|
| PROPOSED LEVEL (FRL) | 198.157 | 198.617 | 199.039 | 198.638 | 197.813 | 196.229 | 194.620 | 193.051 | 191.829 | 191.080 | 190.651 | 190.231 | 189.811 | 189.391 | 188.971 | 188.551 | 188.131 | 187.711 | 187.291 | 186.871 | 186.451 | 186.031 | 185.611 | 185.191 | 184.771 | 184.351 | 183.931 | 183.511 | 183.091 | 182.671 | 182.251 | 181.831 | 181.411 | 180.991 | 180.571 | 180.151 | 180.731 | 180.311 | 180.
|---|














MERANGKONG

MON

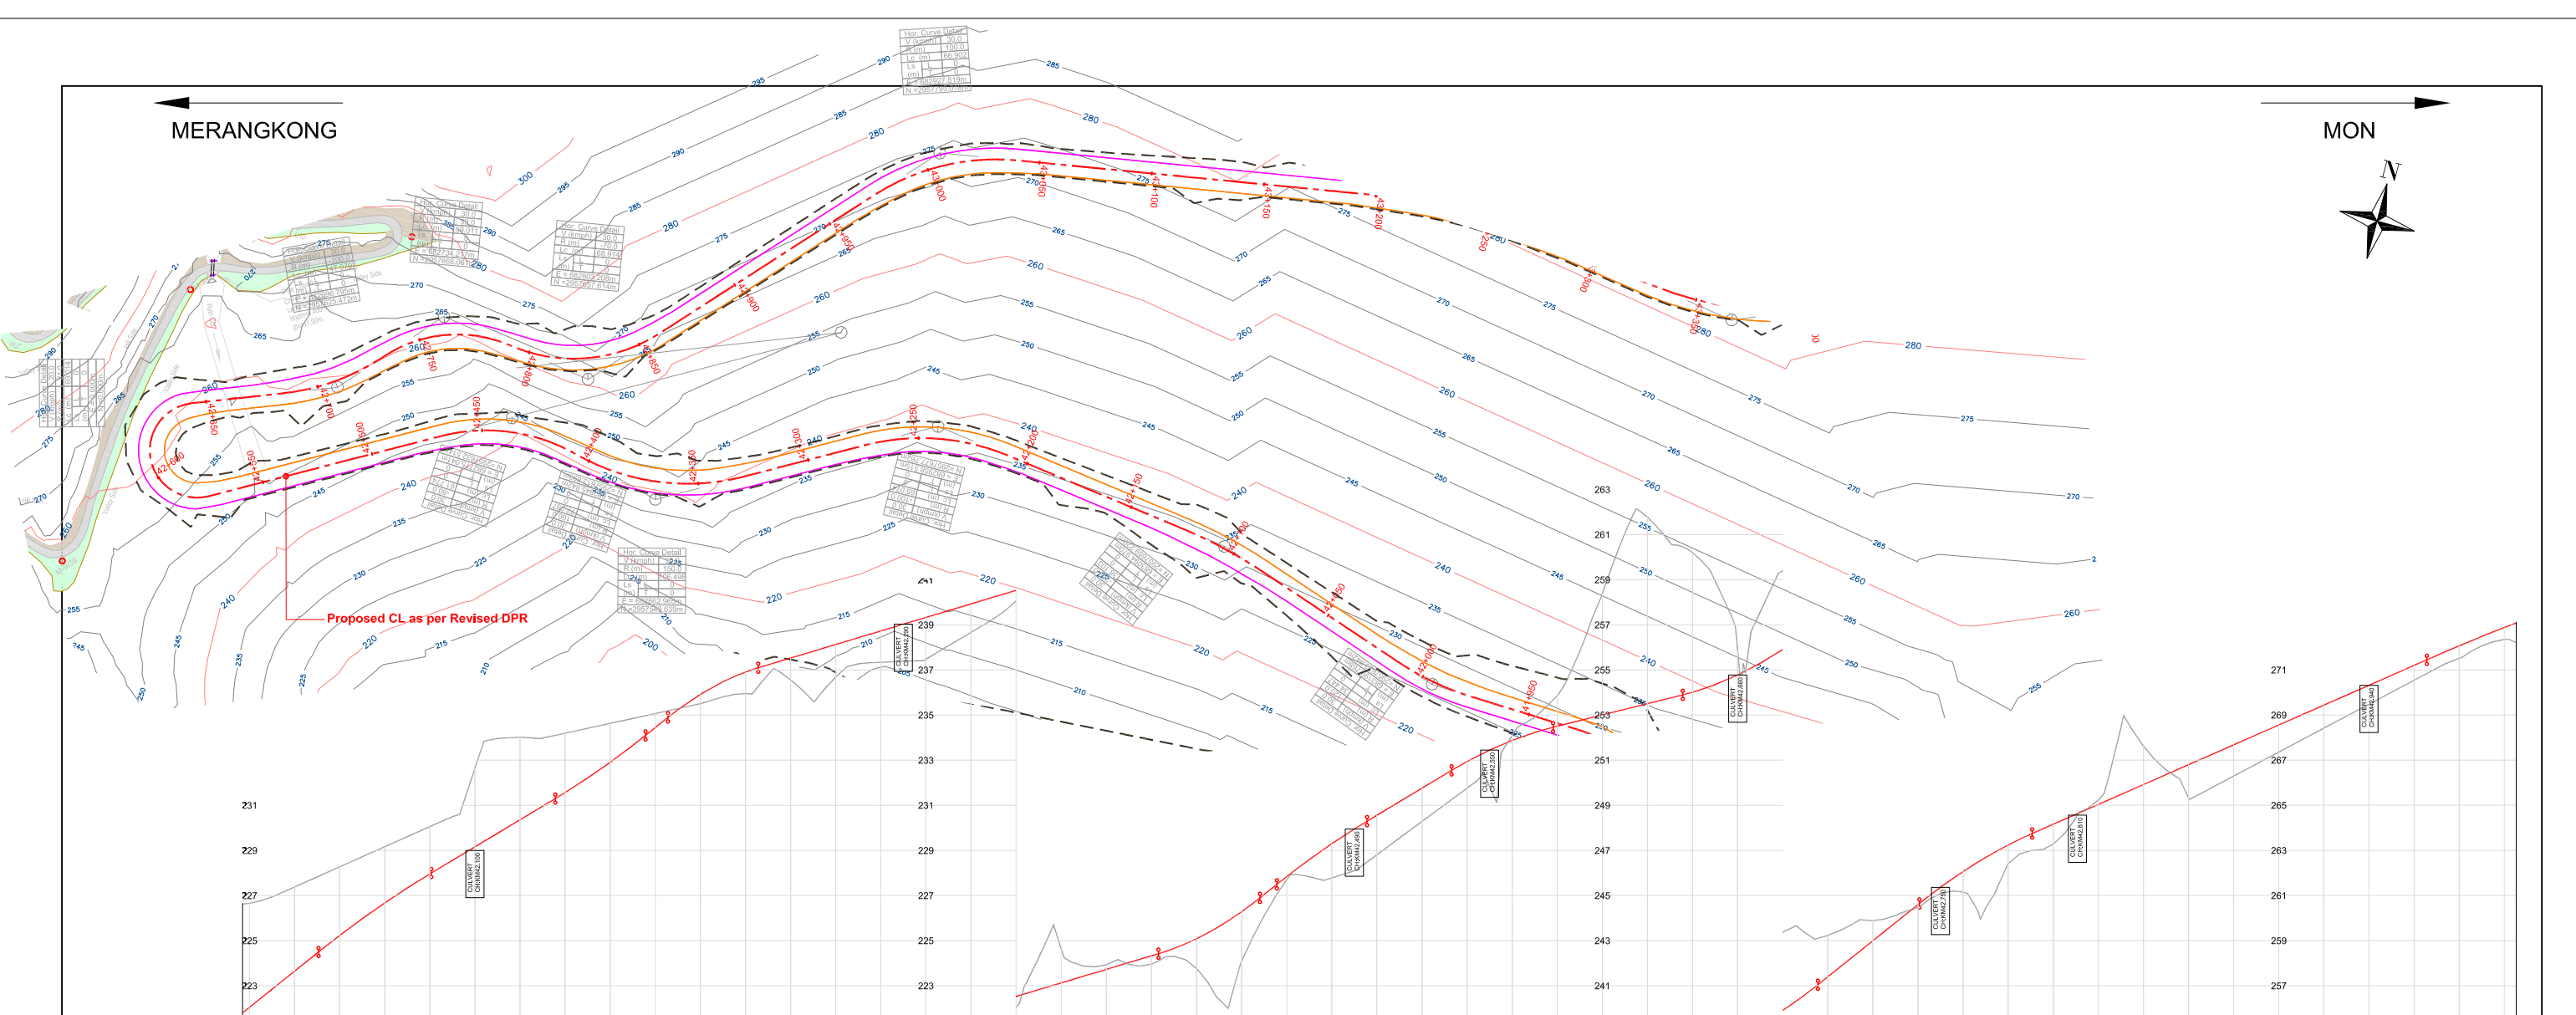

Proposed CL as per Revised DPR

| |
|---|
| PROPOSED LEVEL (FRL) | 222.045 | 223.645 | 225.228 | 226.673 | 227.958 | 229.158 | 230.358 | 231.563 | 232.907 | 234.445 | 235.917 | 236.908 | 237.528 | 238.128 | 237.340 | 238.728 | 239.328 | 239.928 | 
| EXISTING LEVEL (NGL) | 226.654 | 227.379 | 228.272 | 229.164 | 230.056 |

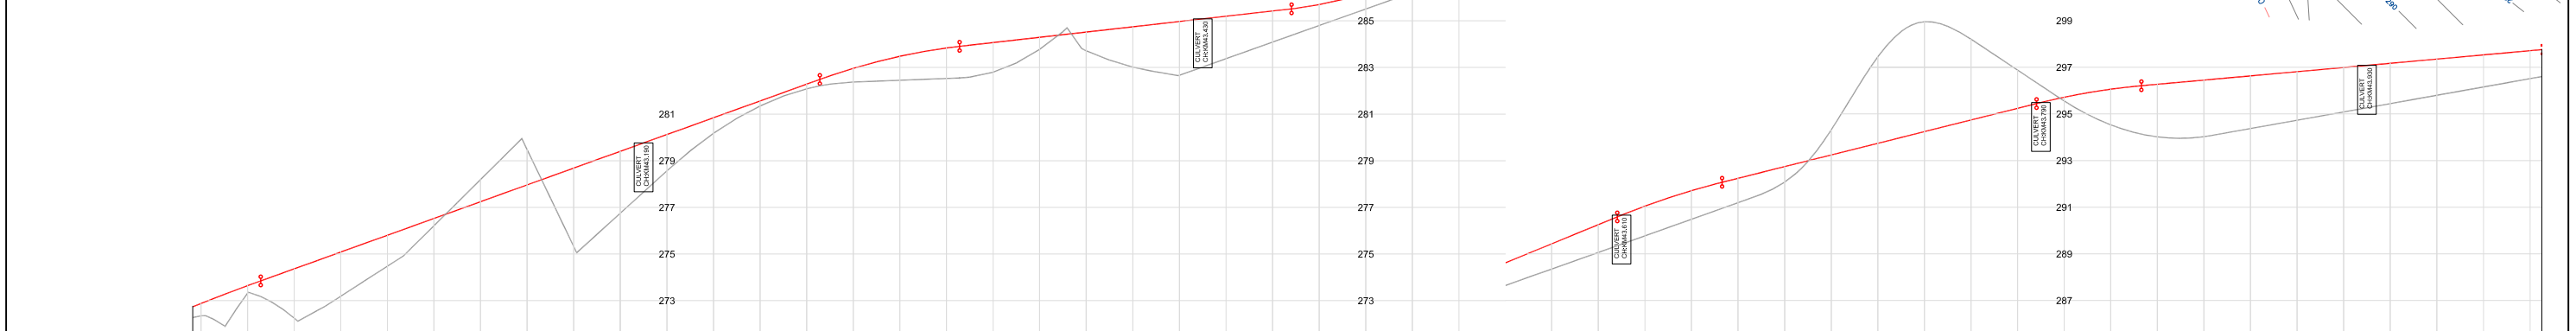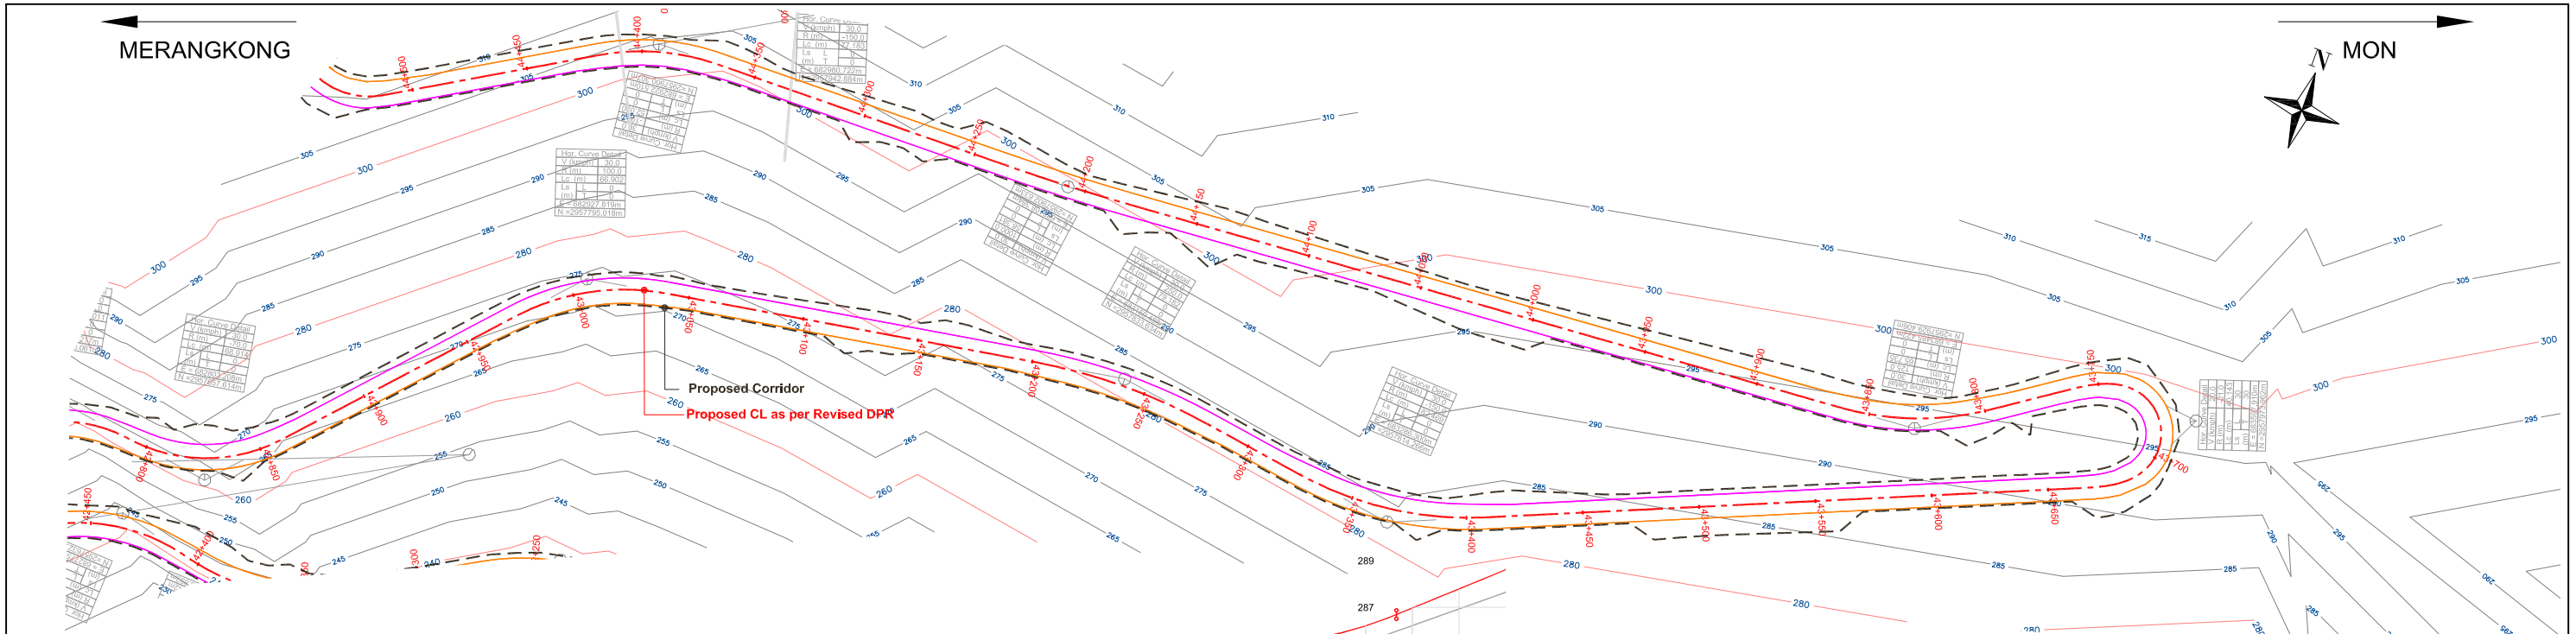

| |
|---|
| PROPOSED LEVEL (FRL)          | 272.880   | 273.642 | 274.364           | 275.084 | 275.804 | 276.524 | 277.244             | 277.964 | 278.684           | 279.404 | 280.124             | 280.844 | 281.564          | 282.284 | 283.004 | 283.724 | 284.444 | 285.164 | 285.884            | 286.604 | 287.324 | 288.044 | 288.764           | 289.484 | 290.204             | 290.924 | 291.644 | 292.364 | 293.084 | 293.804 | 294.524 | 295.244 | 295.964 | 296.684 | 297.404 | 298.124 | 298.844 | 299.564 |         |         |         |         |         |         |         |         |         |         |        |        |        |
| EXISTING LEVEL (NGL)          | 272.348   | 273.322 | 272.255           | 273.191 | 274.476 | 276.214 | 278.194             | 279.480 | 275.324           | 276.753 | 278.566             | 280.174 | 281.349          | 282.085 | 282.375 | 282.451 | 282.528 | 282.796 | 283.376            | 284.087 | 285.421 | 285.693 | 286.208           | 286.971 | 287.791             | 288.611 | 289.431 | 290.251 | 291.046 | 291.710 | 292.241 | 292.741 | 293.241 | 293.741 | 294.241 | 294.741 | 295.241 | 295.716 | 296.080 | 296.271 | 296.451 | 296.631 | 296.811 | 296.991 | 297.171 | 297.351 | 297.531 | 297.711 |        |        |        |
| LEVEL DIFF. (FRL - NGL)       | 0.531   | 0.320   | 2.109             | 1.893   | 1.328   | 0.310   | -0.950              | -1.517  | 3.360             | 2.651   | 1.558               | 0.670   | 0.214            | 0.199   | 0.586   | 1.029   | 1.308   | 1.272   | 0.519              | 0.805   | 1.729   | 2.304   | 1.819             | 1.335   | 0.896               | 0.699   | 0.752   | 0.881   | 0.971   | 1.080   | 1.189   | 1.274   | 1.228   | 1.048   | 0.686   | -1.074  | -3.707  | -4.713  | -3.464  | -1.639  | 0.161   | 1.529   | 2.255   | 2.427   | 2.258   | 2.082   | 1.905   | 1.728   | 1.552  | 1.375  | 1.198  |
| HORIZONTAL                    | R=100.0m<br>L=66.9m   |         | L=160.2m          |         |         |         | R=250.0m<br>L=79.2m |         | L=46.1m           |         | R=150.0m<br>L=82.5m |         | L=255.9m         |         |         |         | L=30.0m |         | R=21.0m<br>L=40.1m |         | L=30.0m |         | L=33.5m           |         | R=125.0m<br>L=65.7m |         |         
| SUPERELEVATION                | 4.00%   |         | 2.50%             |         |         |         | 2.50%               |         | 2.50%             |         | 2.67%               |         | 2.50%            |         |         |         | 7.00%   |         | 7.00%              |         | -7.00%  |         | 2.50%             |         | 3.20%               |         |         
| CURVE WIDENING                | 5.9   |         | 5.6               |         |         |         | 5.6                 |         | 5.6               |         | 5.6                 |         | 5.6              |         |         |         | 5.6     |         | 5.6                |         | 5.6     |         | 5.6               |         | 5.6                 |         | 5.6     |         |         
| VERTICAL SCHEMATIC            | 0.0m  |         | G=3.6<br>L=240.0m |         |         |         | L=60.0m             |         | G=1.1<br>L=142.5m |         | L=45.0m             |         | G=4.1<br>L=95.0m |         |         |         | L=45.0m |         | G=2.5<br>L=135.0m  |         | L=45.0m |         | G=0.9<br>L=172.5m |         |                     
| WIDENING/IMPROVEMENT PROPOSAL | Geometric Improvement<br>BC = 30mm , DBM = 50MM , WMM = 250mm , GSB = 150mm , SG = 500mm ( CBR > 8% @ 97% @ MDD ) | |
| CHAINAGE                      | 43+000  | 43+020  | 43+040            | 43+060  | 43+080  | 43+100  | 43+120              | 43+140  | 43+160            | 43+180  | 43+200              | 43+220  | 43+240           | 43+260  | 43+280  | 43+300  | 43+320  | 43+340  | 43+360             | 43+380  | 43+400  | 43+420  | 43+440            | 43+460  | 43+480              | 43+500  | 43+520  | 43+540  | 43+560  | 43+580  | 43+600  | 43+620  | 43+640  | 43+660  | 43+680  | 43+700  | 43+720  | 43+740  | 43+760  | 43+780  | 43+800  | 43+820  | 43+840  | 43+860  | 43+880  | 43+900  | 43+920  | 43+940  | 43+960 | 43+980 | 44+000 |

**Notes :**  
1) All Levels are in m unless otherwise indicated.

**Legend :**

- Proposed CL : [Red line]
- Proposed Edges : [Orange lines]
- Contours 20m Interval : [Red dashed line]
- Contours 5m Interval : [Blue dashed line]
- Proposed Major Bridge : [Blue rectangle]
- Proposed Minor Bridge : [Green rectangle]
- Proposed Pipe Culvert : [Blue rectangle]
- Proposed Slab Culvert : [Green rectangle]
- Proposed Box Culvert : [Blue rectangle]
- Existing Road : [Grey line]
- Existing Hill : [Brown shaded area]
- Existing Valley : [Green shaded area]
- Existing Hill Cutting Line : [Red dashed line]
- Existing Hill Toe Line : [Orange dashed line]
- Existing Valley Line : [Green dashed line]
- Important Buildings : [Orange rectangle]
- Other Buildings/Huts/Tile house : [Blue rectangle]

**Client :** Ministry of Road Transport & Highways (Government of India)

**Consultant :** RITES LIMITED, RITES BHAWAN, Plot No. 1, Sector- 29, Gurgaon-122001

**Project :** Preparation of Revised Detailed Project Report and Verification of Executed Quantities/Items for Widening to 2 Lane of Merangkong-Tamlu-Mon Road, Changtongya-Longleng Road, Chakabama-Zunheboto Road & Pftusero-Phek Road under Phase 'A' of SARDP-NE in the State of Nagaland



**Scale :** Horizontal 1:50, 1:75, 1:100; Vertical 1:5, 1:7.5, 1:10

**Title :** ALIGNMENT PLAN & PROFILE : MERANGKONG TAMLU MON ROAD

**Page No. :** 44

**Revision Table:**

| Revision | Date      | Stage / Report  | Topography | Designed | Drawn | Checked  | Approved        |
|----------|-----------|-----------------|------------|----------|-------|----------|-----------------|
| R0       | Sep. 2017 | Tender Drawings | NKM / RJ   | DR       | DR    | NKS & NK | Tapas Mukherjee |

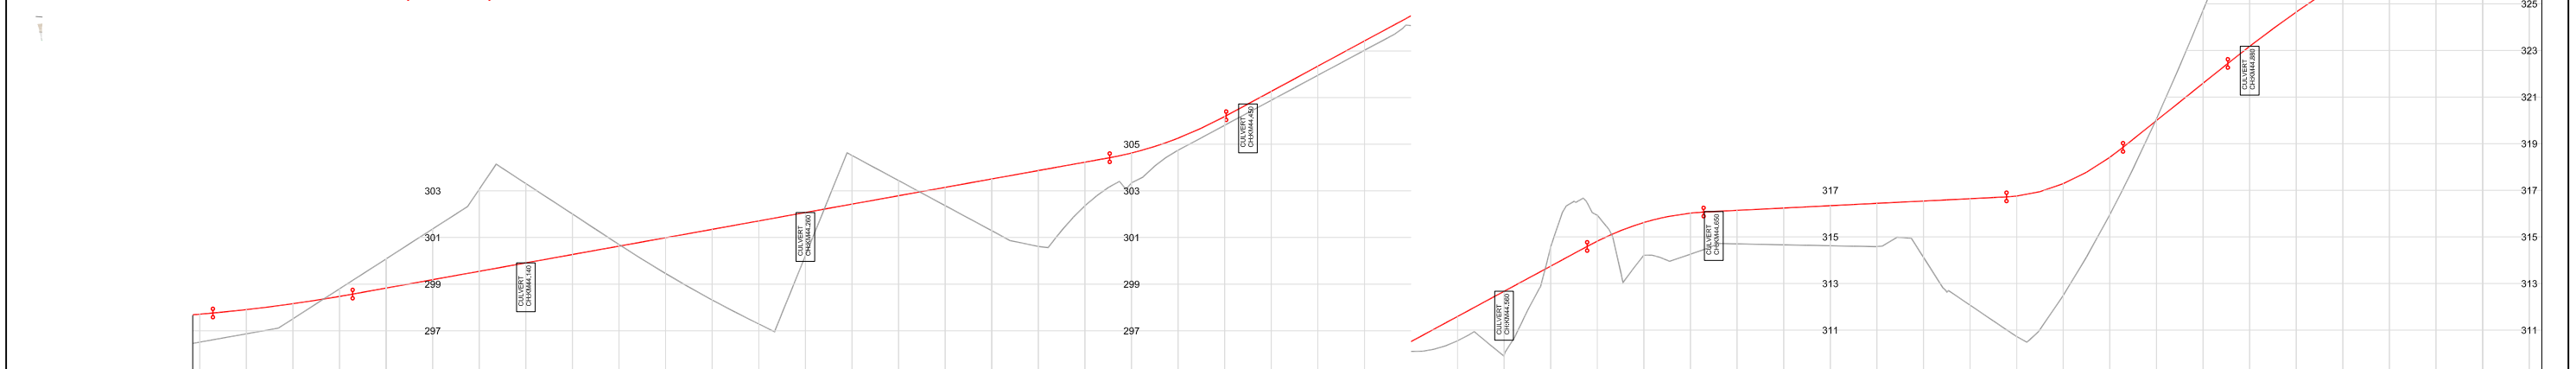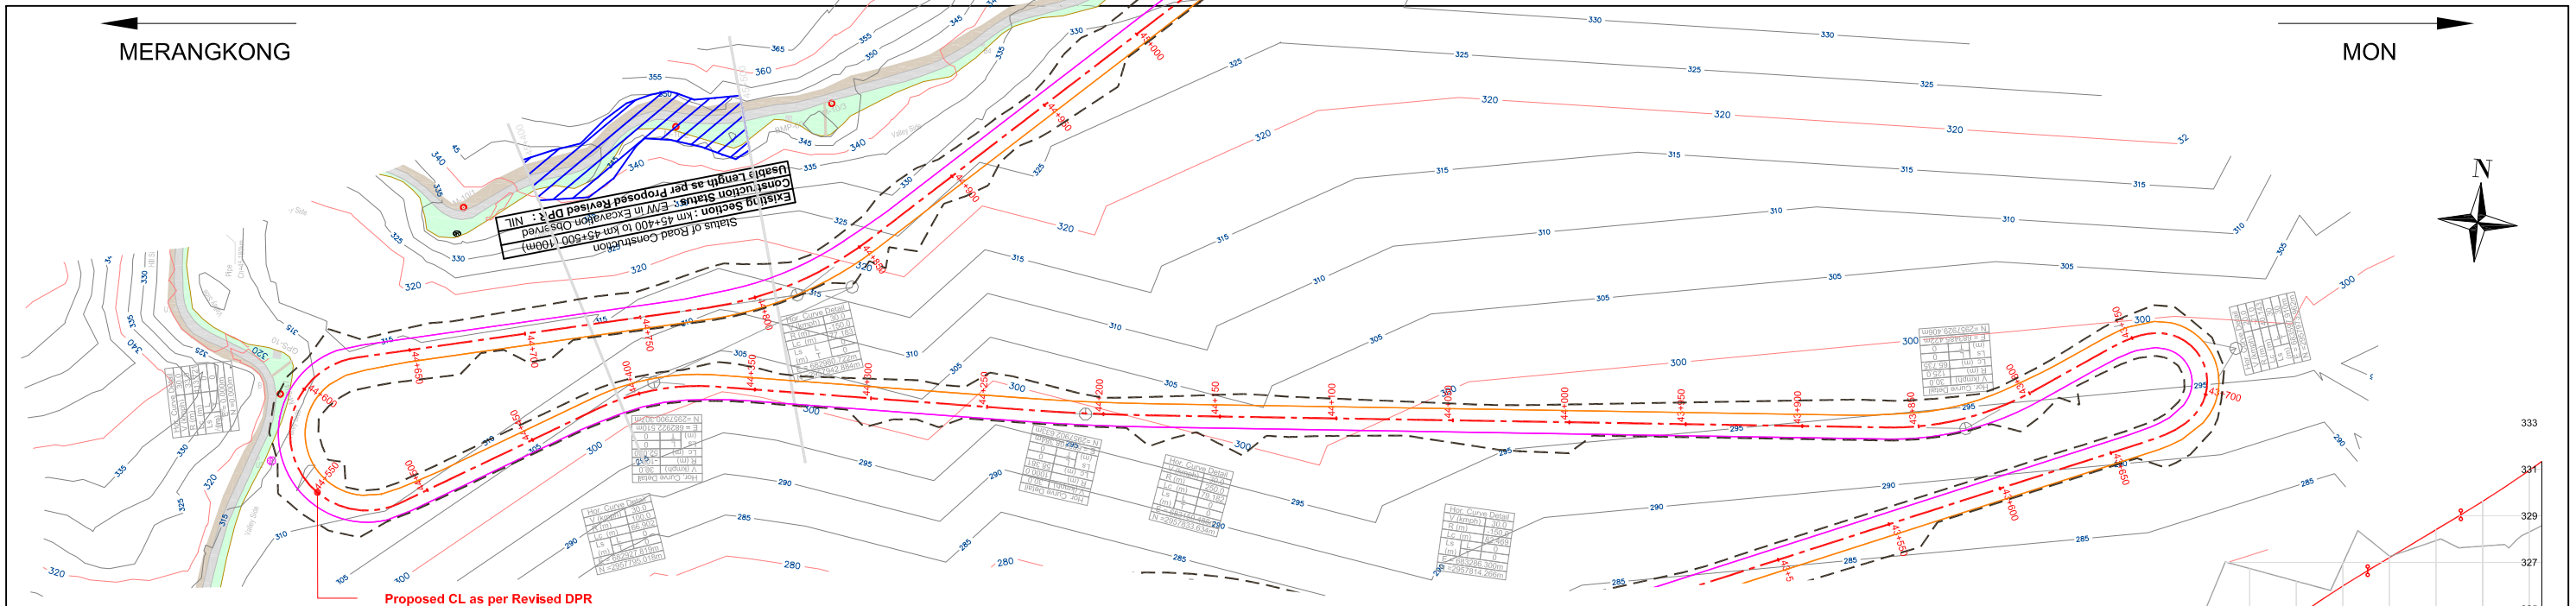

| |
|---|
| PROPOSED LEVEL (FRL)          | 297.711   | 297.907 | 298.160              | 298.473 | 298.830  | 299.190 | 299.550             | 299.910 | 300.270 | 300.630 | 300.990             | 301.350 | 301.710                     | 302.070 | 302.430                     | 302.790 | 303.150  | 303.510 | 303.870 | 304.230 | 304.590 | 304.950 | 305.310 | 305.670 | 306.030 | 306.390 | 306.750 | 307.110 | 307.470 | 307.830 | 308.190 | 308.
| EXISTING LEVEL (NGL)          | 296.513   | 296.870 | 297.514              | 298.798 | 300.083  | 301.368 | 303.072             | 303.313 | 302.006 | 300.699 | 299.455             | 298.319 | 297.292                     | 300.222 | 304.518                     | 303.443 | 302.368  | 301.292 | 300.617 | 302.362 | 303.341 | 304.622 | 305.261 | 305.813 | 306.187 | 306.884 | 307.267 | 307.956 | 308.347 | 309.027 | 309.427 | 310.088 | 310.507 | 310.845 | 311.587 | 309.925 | 312.667 | 314.574 | 315.931 | 314.818 | 315.616 | 314.262 | 316.023 | 314.700 | 316.139 | 314.661 | 316.239 | 314.621 | 316.339 | 314.585 | 316.439 | 314.125 | 316.539 | 312.071 | 316.639 | 310.725 | 316.753 | 312.493 | 317.284 | 315.956 | 318.414 | 320.060 | 319.990 | 324.721 | 321.590 | 326.734 | 323.176 | 326.192 | 324.647 | 326.946 | 325.984 | 327.271 | 327.203 | 327.938 | 328.403 | 327.696 | 329.168 | 328.303 | 328.303 |         |         
| LEVEL DIFF. (FRL - NGL)       | 1.198   | 1.037   | 0.646                | -0.326  | -1.252   | -2.177  | -3.522              | -3.403  | -1.736  | -0.069  | 1.536               | 3.031   | 4.418                       | 1.848   | -2.088                      | -0.652  | 0.783    | 2.218   | 3.254   | 1.868   | 1.281   | 0.519   | 0.375   | 0.383   | 0.392   | 0.400   | 0.420   | 1.045   | 2.742   | -0.826  | -1.114  | 1.403   | 1.762   | 1.438   | 1.578   | 1.717   | 1.853   | 2.414   | 4.567   | 6.028   | 4.791   | 2.458   | -0.069  | -3.130  | -3.559  | -1.545  | -0.961  | -0.068  | 0.466   | 1.921   | 2.643   | |
| HORIZONTAL                    | L=315.1m  |         | R=1000.0m<br>L=58.4m |         | L=130.1m |         | R=100.0m<br>L=52.0m |         | L=94.1m |         | R=33.0m<br>L=113.7m |         | L=151.9m                    |         | R=150.0m<br>L=77.2m         |         | L=179.9m | |
| SUPERELEVATION                | 2.50%   |         | 2.50%                |         | 2.50%    |         | 4.00%               |         | 2.50%   |         | 7.00%               |         | 2.50%                       |         | 2.67%                       |         | 2.50%    | |
| CURVE WIDENING                |   |         |                      |         | 5.9      |         |                     |         |         |         | 6.5                 |         |                             |         | 5.6                         | |
| VERTICAL SCHEMATIC            | L=60.0m   |         | G=1.8<br>L=325.0m    |         | L=50.0m  |         | G=5.4<br>L=155.0m   |         | L=50.0m |         | G=0.5<br>L=130.0m   |         | L=50.0m<br>G=8.0<br>L=45.0m |         | L=60.0m<br>G=6.0<br>L=40.0m |         | L=60.0m  | |
| WIDENING/IMPROVEMENT PROPOSAL | Geometric Improvement<br>BC = 30mm , DBM = 50MM , WMM = 250mm , GSB = 150mm , SG = 500mm ( CBR > 8% @ 97% @ MDD ) | |
| CHAINAGE                      | 44+000  | 44+020  | 44+040               | 44+060  | 44+080   | 44+100  | 44+120              | 44+140  | 44+160  | 44+180  | 44+200              | 44+220  | 44+240                      | 44+260  | 44+280                      | 44+300  | 44+320   | 44+340  | 44+360  | 44+380  | 44+400  | 44+420  | 44+440  | 44+460  | 44+480  | 44+500  | 44+520  | 44+540  | 44+560  | 44+580  | 44+600  | 44+620  | 44+640  | 44+660  | 44+680  | 44+700  | 44+720  | 44+740  | 44+760  | 44+780  | 44+800  | 44+820  | 44+840  | 44+860  | 44+880  | 44+900  | 44+920  | 44+940  | 44+960  | 44+980  | 45+000  | |

Notes :  
1) All Levels are in m unless otherwise indicated.

Legend :  
 Proposed CL : Existing Road :   
 Proposed Edges : Existing Hill :   
 Contours 20m Interval : Existing Valley :   
 Contours 5m Interval : Existing Hill Cutting Line :   
 Proposed Major Bridge : Existing Hill Toe Line :   
 Proposed Minor Bridge : Existing Valley Line :   
 Proposed Pipe Culvert : Important Buildings :   
 Proposed Slab Culvert : Other Buildings/Huts/Tile house :   
 Proposed Box Culvert :


Client : Ministry of Road Transport & Highways (Government of India) Consultant : RITES LIMITED, RITES BHAWAN, Plot No. 1, Sector- 29, Gurgaon-122001

Project : Preparation of Revised Detailed Project Report and Verification of Executed Quantities/Items for Widening to 2 Lane of Merangkong-Tamlu-Mon Road, Changtongya-Longleng Road, Chakabama-Zunheboto Road & Pftusero-Phek Road under Phase 'A' of SARDP-NE in the State of Nagaland

Scale : Horizontal Vertical

Title : ALIGNMENT PLAN & PROFILE : MERANGKONG TAMLU MON ROAD

Page No. 45

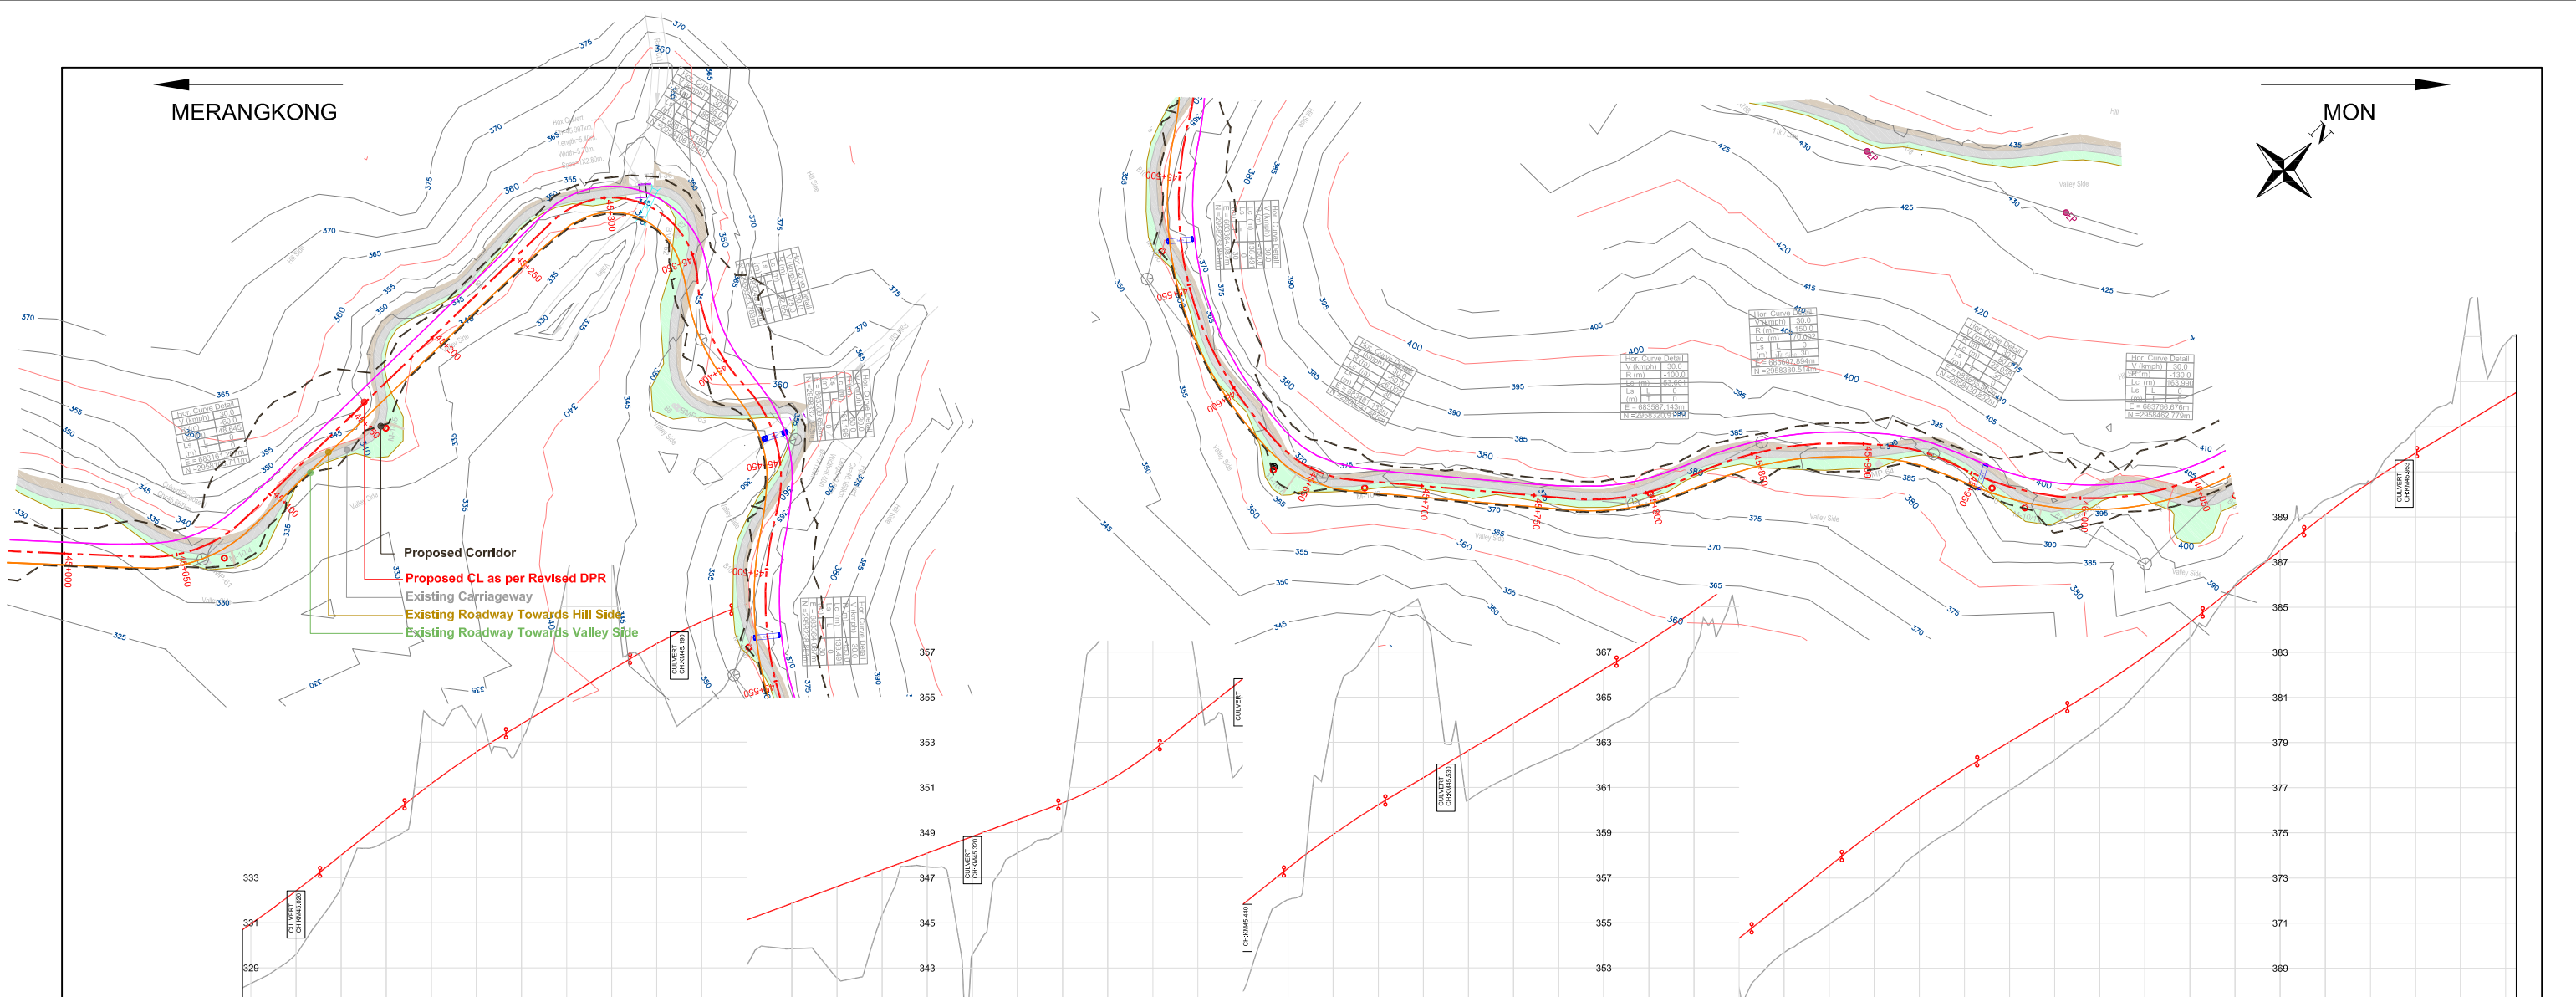

| |
|---|
| PROPOSED LEVEL (FRL)          | 330.947               | 332.409 | 333.990   | 335.590 | 337.159 | 338.565 | 339.803  | 341.003 | 342.203   | 343.367 | 344.344                      | 345.128  | 345.868              | 346.608                     | 347.348 | 348.088                       | 348.828 | 349.568         | 350.310                     | 351.276 | 352.625                     | 354.220 | 355.820             | 357.420 | 358.914            | 360.231 | 361.433 | 362.633 | 363.833 | 365.033 | 366.233 | 367.468 | 368.830 | 370.326 | 371.920 | 373.520 | 375.086 | 376.524 | 377.828 | 379.033 | 380.233 | 381.468 | 382.830 | 384.326 | 385.920 | 387.520 | 389.103 | 390.548 | 391.833 | 393.033 | 394.233 |
| EXISTING LEVEL (NGL)          | 328.303               | 329.598 | 332.531   | 334.607 | 340.022 | 339.695 | 338.053  | 346.231 | 347.350   | 341.539 | 340.549                      | 343.132  | 343.856              | 342.567                     | 345.362 | 347.482                       | 343.592 | 348.103         | 349.404                     | 358.033 | 364.390                     | 355.848 | 351.972             | 356.020 | 364.147            | 367.734 | 368.682 | 360.450 | 361.564 | 362.484 | 363.538 | 364.810 | 367.063 | 368.099 | 369.696 | 370.954 | 372.353 | 374.164 | 375.495 | 376.883 | 378.224 | 379.703 | 381.566 | 383.654 | 386.001 | 388.016 | 389.753 | 390.482 | 392.691 | 395.977 | 396.697 |
| LEVEL DIFF. (FRL - NGL)       | 2.643                 | 2.811   | 1.459   | 0.984   | -2.863  | -1.130  | 0.751  | -5.227  | -5.147  | 1.829   | 3.795                        | 1.996  | 2.013                | 4.042                       | 1.987   | 0.606                         | 5.237   | 1.466           | 0.906                       | -6.757  | -11.765                     | -1.627  | 3.846               | 1.399   | -5.232             | -7.502  | -7.249  | 2.184   | 2.270   | 2.549   | 2.696   | 2.658   | 1.766   | 2.227   | 2.224   | 2.567   | 2.732   | 2.359   | 2.332   | 2.151   | 2.009   | 1.765   | 1.243   | 0.671   | -0.080  | -0.495  | -0.650  | 0.066   | -1.057  | -2.944  | -2.464  |
| HORIZONTAL                    | R=60.0m<br>L=48.6m    |         | L=189.7m  |         |         |         | R=38.0m<br>L=86.6m   |         | R=75.0m<br>L=52.6m                                      |         | R=60.0m<br>L=61.2m           |  | R=150.0m<br>L=138.5m |                             |         | R=50.0m<br>L=30.0m<br>L=26.0m |         | L=97.8m         |                             |         | R=100.0m<br>L=53.6m         |         | R=150.0m<br>L=70.0m |         | L=30.0m<br>L=22.1m |         | R=80.0m |         |         
| SUPERELEVATION                | 6.67%<br>-6.67%       |         | 2.50%<br>-2.50%   |         |         |         | 7.00%<br>-7.00%  |         | 5.33%<br>-5.33%   |         | 6.67%<br>-6.67%              |  | 2.67%<br>-2.67%      |                             |         | 7.00%<br>-7.00%               |         | 2.50%<br>-2.50% |                             |         | 4.00%<br>-4.00%             |         | 2.67%<br>-2.67%     |         | 5.00%<br>-5.00%    |         |         
| CURVE WIDENING                | 6.2                   |         | 6.5   |         |         |         | 5.9  |         | 6.2   |         | 5.6                          |  |                      | 6.2                         |         | 5.9                           |         |                 | 5.6                         |         | 5.9                         |         |                     
| VERTICAL SCHEMATIC            | G=8.0<br>L=37.5m      |         | G=6.0<br>L=45.0m<br>L=55.0m<br>L=45.0m                  |         |         |         | G=3.7<br>L=145.0m  |         | L=45.0m<br>G=8.0<br>L=55.0m                             |         | L=45.0m<br>G=6.0<br>L=102.5m |  |                      | L=60.0m<br>G=8.0<br>L=40.0m |         | L=60.0m<br>G=6.0<br>L=40.0m   |         |                 | L=60.0m<br>G=8.0<br>L=45.0m |         | L=50.0m<br>G=6.0<br>L=50.0m |         |                     
| WIDENING/IMPROVEMENT PROPOSAL | Geometric Improvement |         | Widening on Left Side (Hill) with Geometric Improvement |         |         |         | Widening on Right Side (Valley) with Geometric Improvement |         | Widening on Left Side (Hill) with Geometric Improvement |         |                              | Widening on Right Side (Valley) with Geometric Improvement | |
| CHAINAGE                      | 45+000                | 45+020  | 45+040  | 45+060  | 45+080  | 45+100  | 45+120   | 45+140  | 45+160  | 45+180  | 45+200                       | 45+220   | 45+240               | 45+260                      | 45+280  | 45+300                        | 45+320  | 45+340          | 45+360                      | 45+380  | 45+400                      | 45+420  | 45+440              | 45+460  | 45+480             | 45+500  | 45+520  | 45+540  | 45+560  | 45+580  | 45+600  | 45+620  | 45+640  | 45+660  | 45+680  | 45+700  | 45+720  | 45+740  | 45+760  | 45+780  | 45+800  | 45+820  | 45+840  | 45+860  | 45+880  | 45+900  | 45+920  | 45+940  | 45+960  | 45+980  | 46+000  |

Notes :  
1) All Levels are in m unless otherwise indicated.

|                         |                                   |
|-------------------------|-----------------------------------|
| Proposed CL :           | Existing Road :                   |
| Proposed Edges :        | Existing Hill :                   |
| Contours 20m Interval : | Existing Valley :                 |
| Contours 5m Interval :  | Existing Hill Cutting Line :      |
| Proposed Major Bridge : | Existing Hill Toe Line :          |
| Proposed Minor Bridge : | Existing Valley Line :            |
| Proposed Pipe Culvert : | Important Buildings :             |
| Proposed Slab Culvert : | Other Buildings/Huts/Tile house : |
| Proposed Box Culvert :  |                                   |

|          |           |                 |            |          |       |          |                 |
|----------|-----------|-----------------|------------|----------|-------|----------|-----------------|
| R0       | Sep. 2017 | Tender Drawings | NKM / RJ   | DR       | DR    | NKS & NK | Tapas Mukherjee |
| Revision | Date      | Stage / Report  | Topography | Designed | Drawn | Checked  | Approved        |

Client : Ministry of Road Transport & Highways (Government of India)

Consultant : RITES LIMITED, RITES BHAWAN, Plot No. 1, Sector- 29, Gurgaon-122001



Project : Preparation of Revised Detailed Project Report and Verification of Executed Quantities/Items for Widening to 2 Lane of Merangkong-Tamlu-Mon Road, Changtongya-Longleng Road, Chakabama-Zunhebot Road & Pftusero-Phek Road under Phase 'A' of SARDP-NE in the State of Nagaland

Scale : Horizontal 1:50, 1:75, 1:100; Vertical 1:5, 1:7.5, 1:10

Title : ALIGNMENT PLAN & PROFILE : MERANGKONG TAMLU MON ROAD

Page No. 46

MERANGKONG

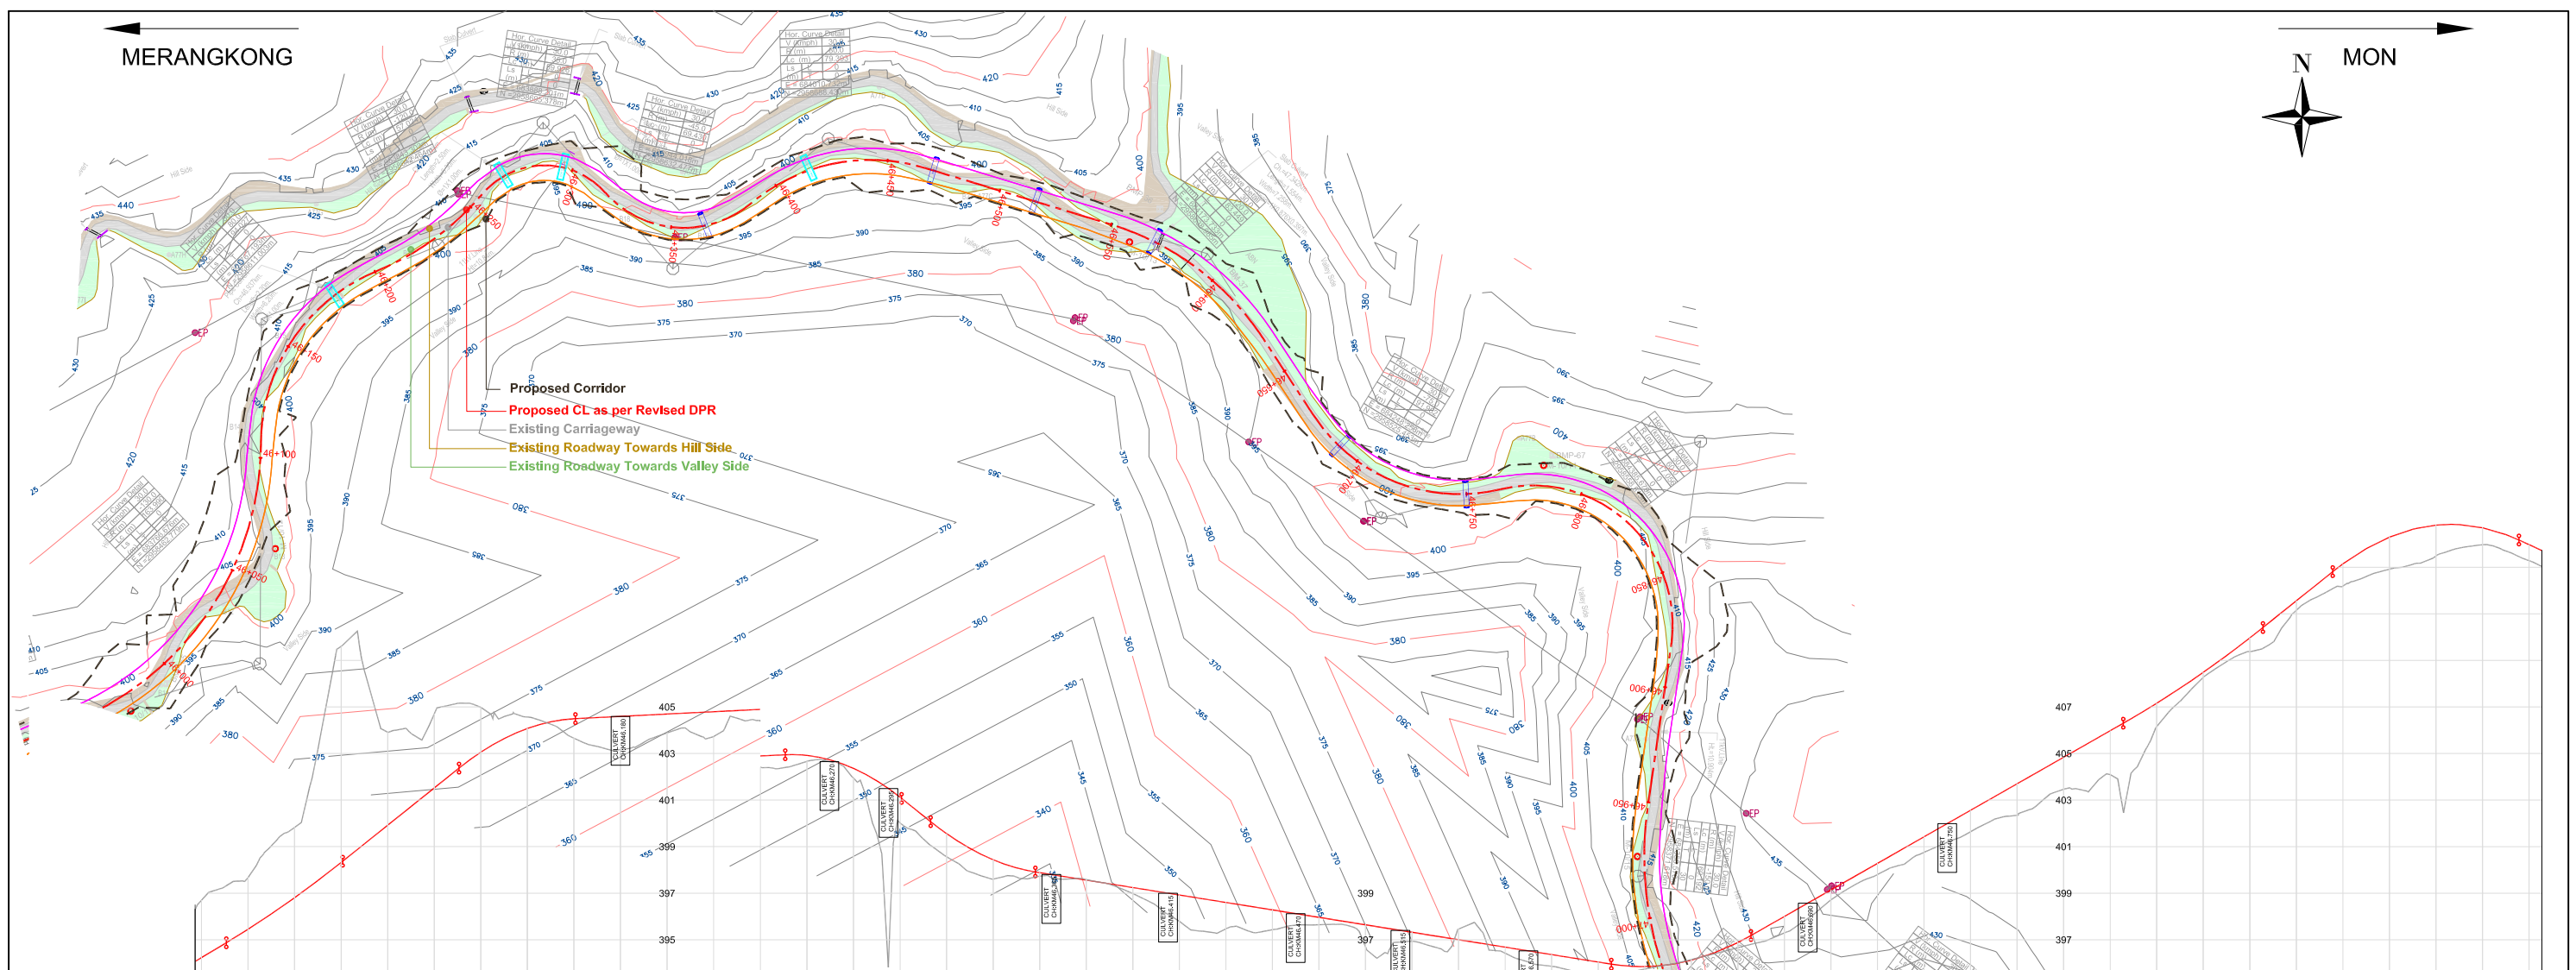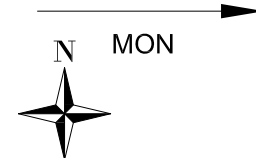

| |
|---|
| PROPOSED LEVEL (FRL)          | 394.233  | 396.697 | 397.672            | 399.823 | 398.806             | 398.320 | 399.920            | 401.520 | 403.055            | 404.074 | 404.493            | 404.594 | 404.694            | 404.794 | 404.894             | 404.919 | 404.361           | 402.018 | 403.123            | 401.557 | 400.436             | 399.882 | 399.562          | 399.242 | 398.922             | 398.602 | 397.471 | 397.282 | 397.962 | 397.642 | 397.322 | 397.002 | 396.682 | 396.362 | 396.042 | 395.721 | 395.401 | 396.120 | 396.880 | 398.000 | 399.140 | 400.280 | 401.420 | 402.560 | 403.700 | 404.840 | 405.980 | 407.120 | 408.260 | 409.400 | 405.966 | 411.560 | 413.145 | 414.293 | 414.811 | 414.899 | 413.287 | 413.972 |         |         |
| EXISTING LEVEL (NGL)          | 396.697  | 397.672 | 399.823            | 407.599 | 403.913             | 404.701 | 404.982            | 404.569 | 403.657            | 404.493 | 403.173            | 403.883 | 403.724            | 404.410 | 404.663             | 404.919 | 403.943           | 402.018 | 403.123            | 400.566 | 401.557             | 399.602 | 399.728          | 399.587 | 398.986             | 399.242 | 397.796 | 397.471 | 397.282 | 397.962 | 397.642 | 397.322 | 397.002 | 396.682 | 396.362 | 396.042 | 395.721 | 395.401 | 396.120 | 396.880 | 398.000 | 399.140 | 400.280 | 401.420 | 402.560 | 403.700 | 404.840 | 405.980 | 407.120 | 408.260 | 409.400 | 409.966 | 411.560 | 412.193 | 412.919 | 414.293 | 414.811 | 414.899 | 413.287 | 413.972 |
| LEVEL DIFF. (FRL - NGL)       | -2.464   | -2.222  | -3.017             | -9.279  | -3.992              | -3.181  | -1.928             | -0.494  | 0.837              | 1.421   | 0.811              | 1.069   | 0.483              | 0.256   | 0.418               | 1.105   | 0.991             | 0.835   | 0.155              | -0.025  | 0.257               | 1.127   | 1.131            | 0.851   | 0.317               | 0.938   | 0.391   | -0.455  | 0.260   | 0.504   | 0.496   | 0.106   | -0.030  | 0.222   | 0.705   | 0.430   | 0.479   | 0.666   | 0.922   | 1.351   | 1.378   | 1.888   | 1.002   | 0.214   | 0.590   | 0.409   | 0.953   | 1.374   | 1.328   | 0.732   | 0.684   |         |         |         |         |         |         |         |         |         |
| HORIZONTAL                    | R=130.0m<br>L=164.0m   |         | R=80.0m<br>L=94.0m |         | R=120.0m<br>L=57.0m |         | R=35.0m<br>L=59.9m |         | R=45.0m<br>L=69.4m |         | R=80.0m<br>L=79.4m |         | L=83.5m            |         | R=120.0m<br>L=83.4m |         | L=39.6m           |         | R=75.0m<br>L=92.0m |         | R=60.0m<br>L=117.1m |         | L=69.8m          |         | R=150.0m<br>L=60.2m |         |         
| SUPERELEVATION                | 3.08%  |         | 5.00%              |         | 3.33%               |         | 7.00%              |         | 7.00%              |         | 5.00%              |         | 2.50%              |         | 3.33%               |         | 2.50%             |         | 5.33%              |         | 6.67%               |         | 2.50%            |         | 2.67%               |         |         
| CURVE WIDENING                | 5.6  |         | 5.9                |         | 5.6                 |         | 6.2                |         | 5.9                |         | 5.6                |         | 5.9                |         | 5.6                 |         | 5.9               |         | 6.2                |         | 5.6                 |         | 5.9              |         | 5.6                 |         |         
| VERTICAL SCHEMATIC            | L=50.0m<br>G=8.0   |         | L=50.0m<br>G=0.5   |         | L=50.0m<br>G=0.5    |         | L=90.0m<br>G=0.5   |         | L=50.0m<br>G=0.5   |         | L=45.0m<br>G=-1.6  |         | L=247.5m<br>G=-1.6 |         | L=60.0m<br>G=5.7    |         | L=160.0m<br>G=5.7 |         | L=60.0m<br>G=8.0   |         | L=30.0m<br>G=8.0    |         | L=80.0m<br>G=8.0 |         |                     
| WIDENING/IMPROVEMENT PROPOSAL | Widening on Right Side (Valley) with Geometric Improvement<br>BC = 30mm, DBM = 50MM, WMM = 250mm, GSB = 150mm, SG = 500mm ( CBR > 8% @ 97% @ MDD ) | |
| CHAINAGE                      | 46+000   | 46+020  | 46+040             | 46+060  | 46+080              | 46+100  | 46+120             | 46+140  | 46+160             | 46+180  | 46+200             | 46+220  | 46+240             | 46+260  | 46+280              | 46+300  | 46+320            | 46+340  | 46+360             | 46+380  | 46+400              | 46+420  | 46+440           | 46+460  | 46+480              | 46+500  | 46+520  | 46+540  | 46+560  | 46+580  | 46+600  | 46+620  | 46+640  | 46+660  | 46+680  | 46+700  | 46+720  | 46+740  | 46+760  | 46+780  | 46+800  | 46+820  | 46+840  | 46+860  | 46+880  | 46+900  | 46+920  | 46+940  | 46+960  | 46+980  | 47+000  |         |         |         |         |         |         |         |         |         |

Notes :  
1) All Levels are in m unless otherwise indicated.

Legend :

- Proposed CL : [Red line]
- Proposed Edges : [Red dashed line]
- Contours 20m Interval : [Red line]
- Contours 5m Interval : [Blue line]
- Proposed Major Bridge : [Green line]
- Proposed Minor Bridge : [Blue line]
- Proposed Pipe Culvert : [Blue line]
- Proposed Slab Culvert : [Blue line]
- Proposed Box Culvert : [Blue line]
- Existing Road : [Grey line]
- Existing Hill : [Brown line]
- Existing Valley : [Green line]
- Existing Hill Cutting Line : [Red line]
- Existing Hill Toe Line : [Red line]
- Existing Valley Line : [Red line]
- Important Buildings : [Orange box]
- Other Buildings/Huts/Tile house : [Blue box]

R0 Sep. 2017 Tender Drawings  
Stage / Report  
Topography  
Designed  
Drawn  
Checked  
Approved

Client : Ministry of Road Transport & Highways (Government of India)  
Consultant : RITES LIMITED, RITES BHAWAN, Plot No. 1, Sector- 29, Gurgaon-122001

Project : Preparation of Revised Detailed Project Report and Verification of Executed Quantities/Items for Widening to 2 Lane of Merangkong-Tamlu-Mon Road, Changtongya-Longleng Road, Chakabama-Zunhebot Road & Pftsero-Phek Road under Phase 'A' of SARDP-NE in the State of Nagaland



Scale : Horizontal 1:50, 1:75, 1:100  
Vertical 1:5, 1:7.5, 1:10

Title : ALIGNMENT PLAN & PROFILE : MERANGKONG TAMLU MON ROAD



Page No. 47

MERANGKONG

MON

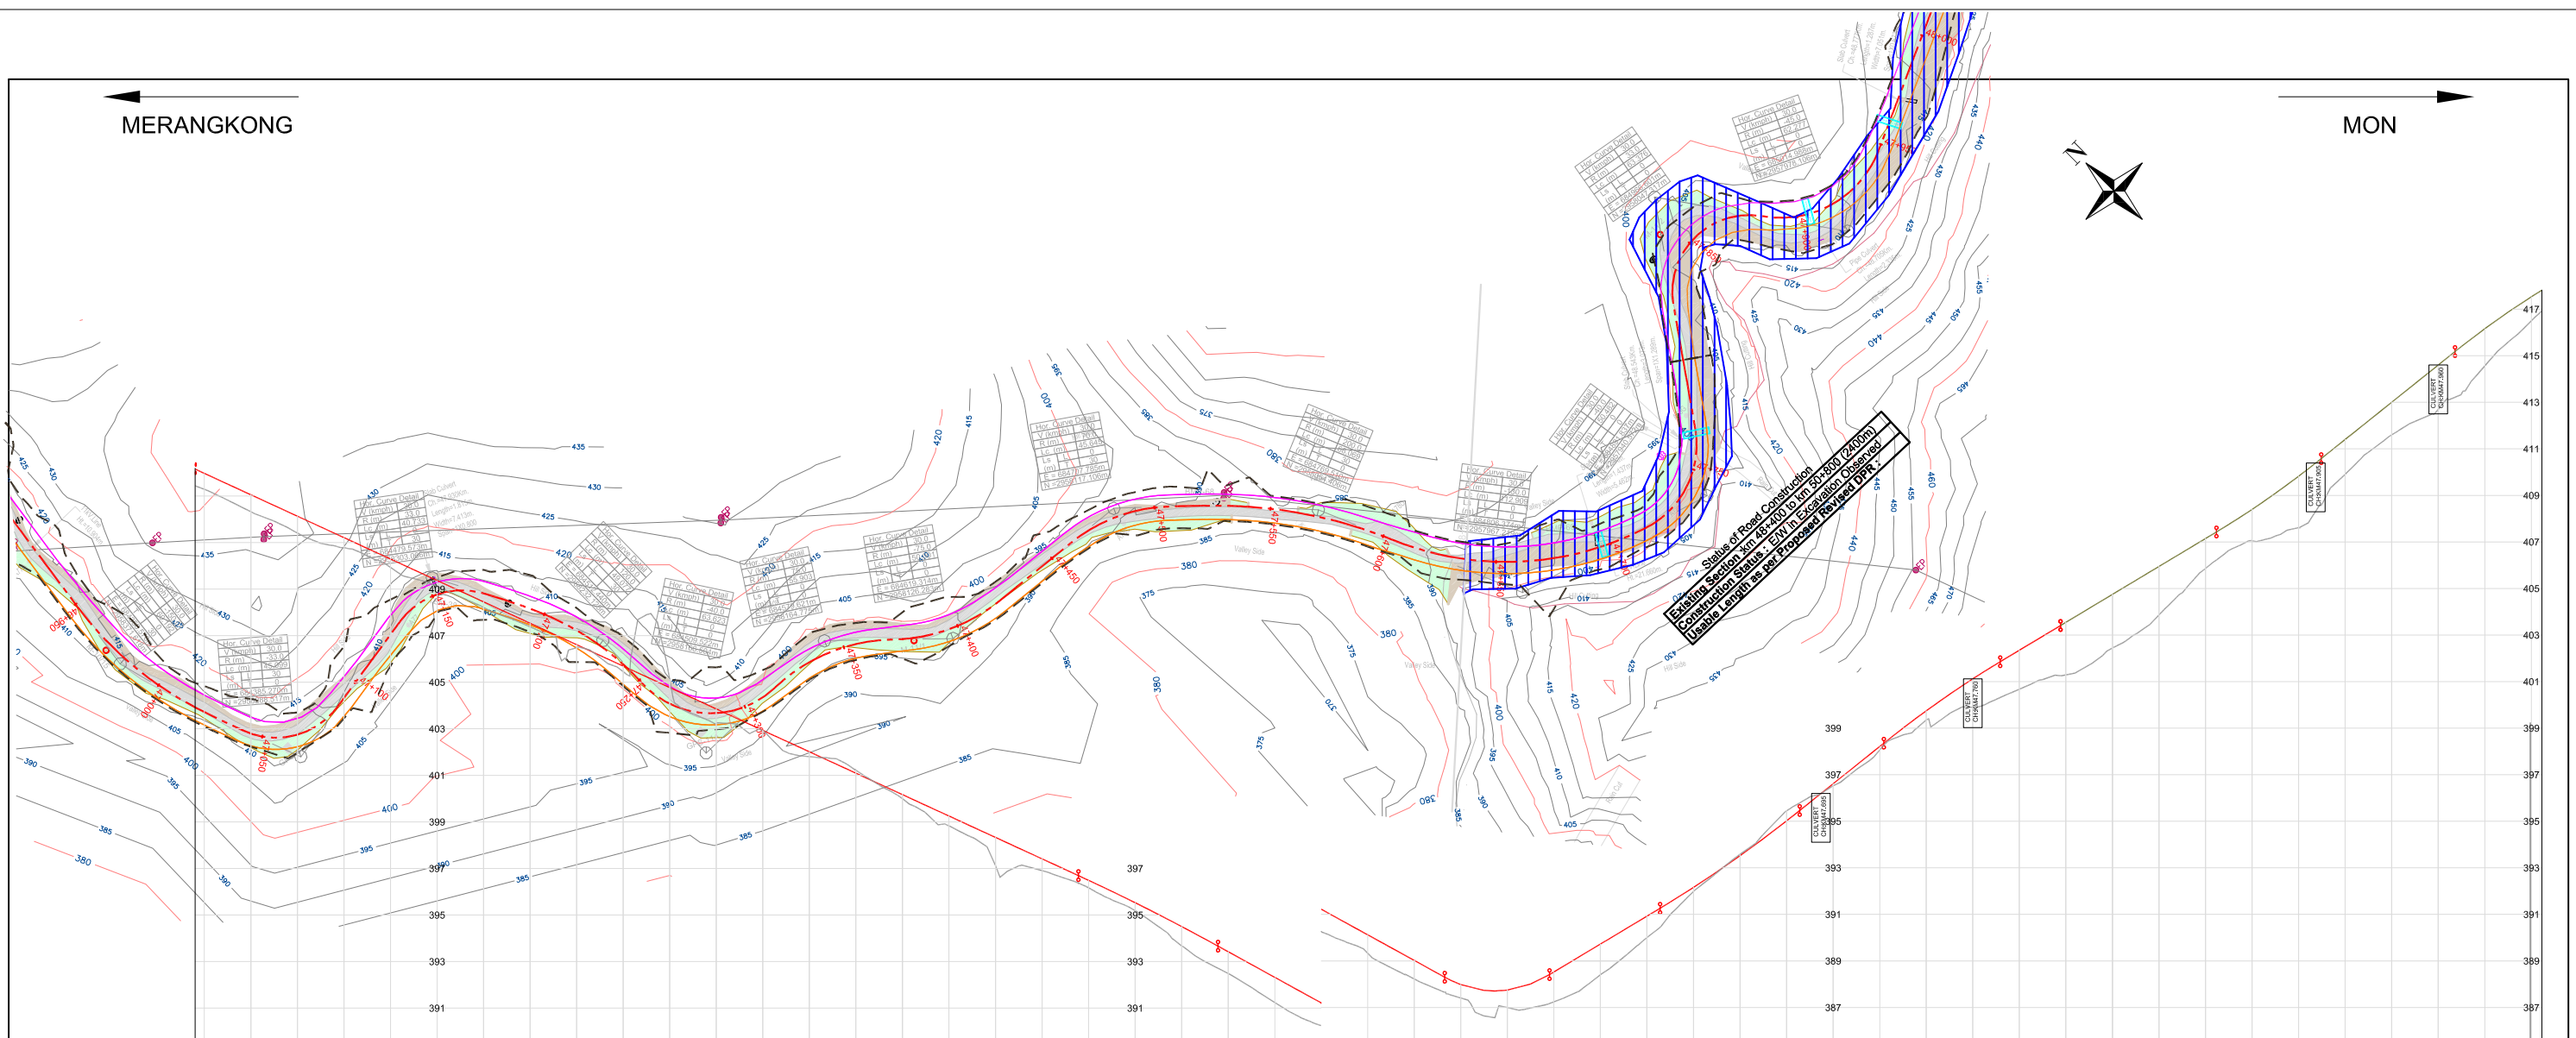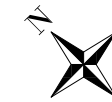

| |
|---|
| PROPOSED LEVEL (FRL) | 413.972 | 413.952 | 412.132 | 411.212 | 410.292 | 409.372 | 408.452 | 407.532 | 406.612 | 405.692 | 404.772 | 403.852 | 402.932 | 402.012 | 401.092 | 400.172 | 399.252 | 388.332 | 387.412 | 386.490 | 385.572 | 384.650 | 383.732 | 382.812 | 381.892 |
|---|

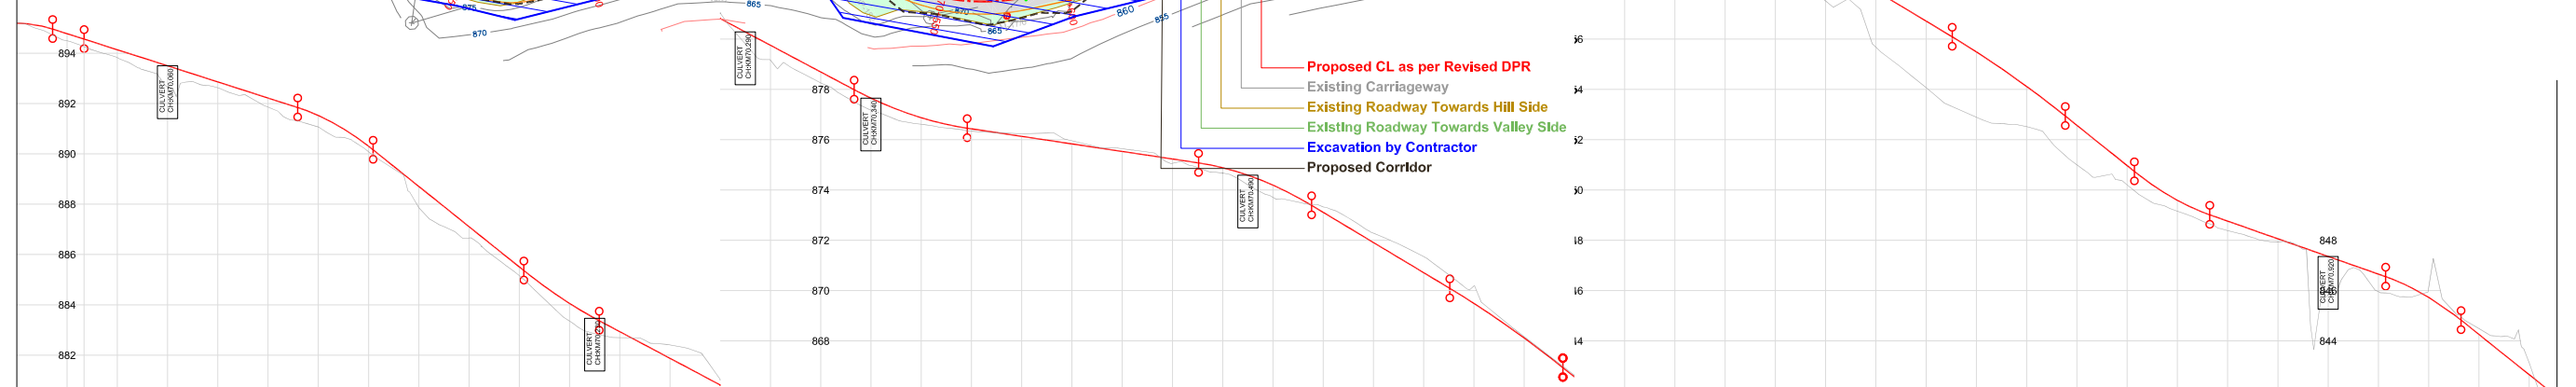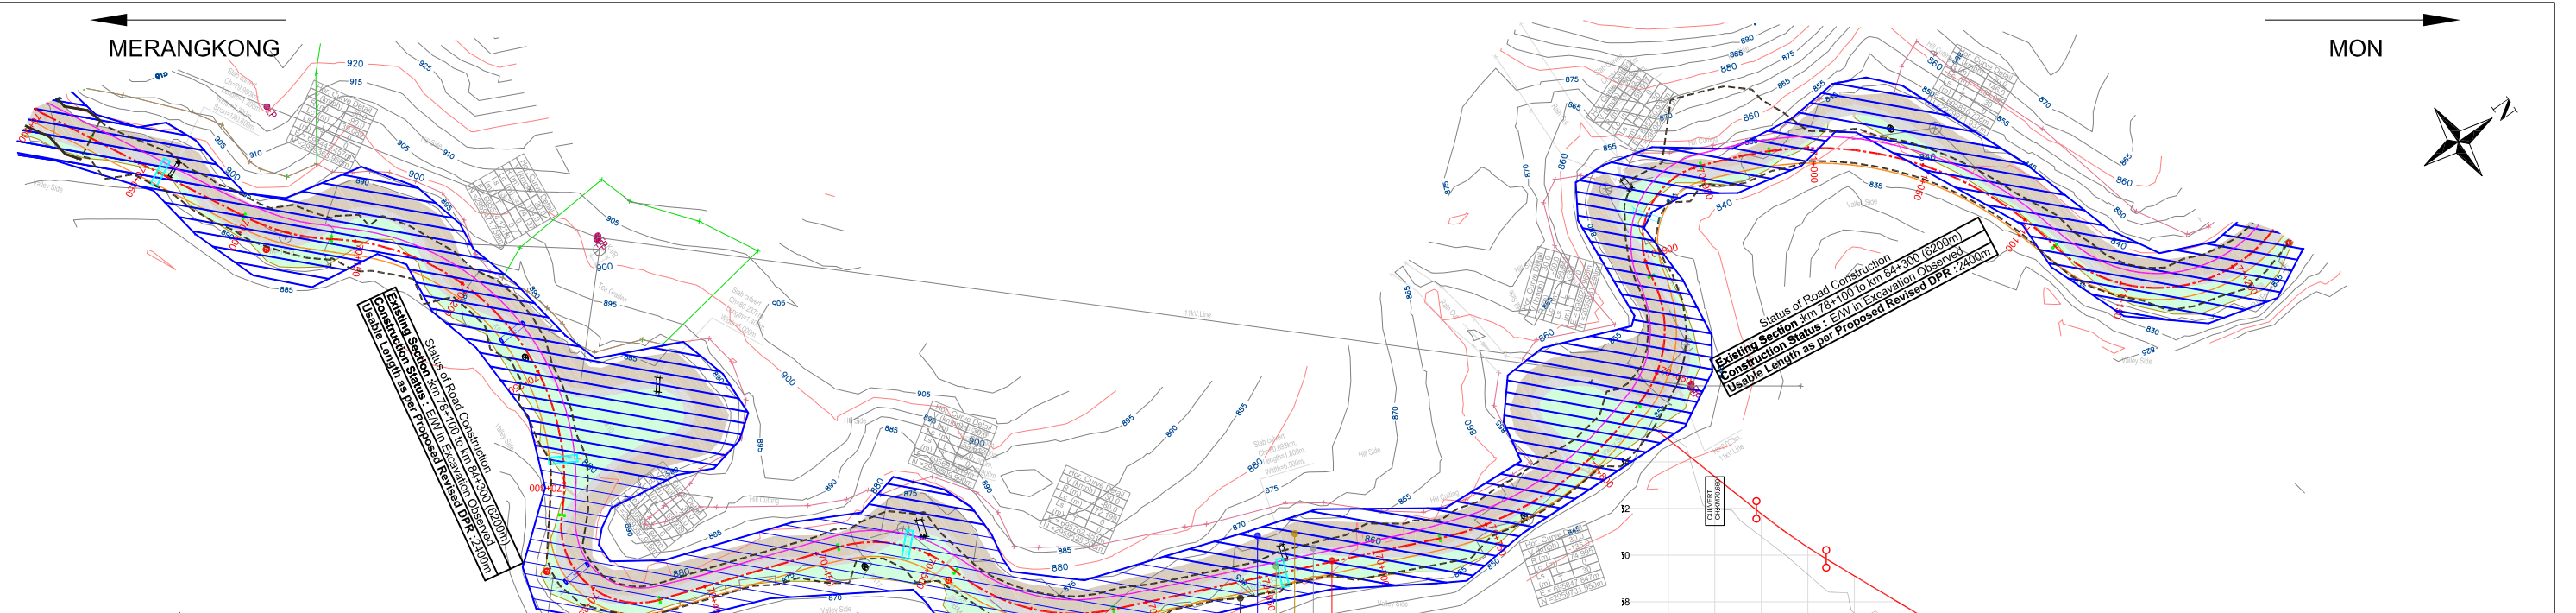

| |
|---|
| PROPOSED LEVEL (FRL)          | 895.194   | 894.778 | 894.560            | 894.138 | 893.498              | 892.859 | 892.219          | 891.526 | 890.304            | 888.706 | 887.106           | 885.506 | 884.055            | 882.933 | 881.873            | 880.813 | 879.753  | 878.693 | 877.652             | 876.614 | 876.432 | 876.132 | 875.932            | 875.640 | 875.532            | 875.062 | 874.886          | 874.194 | 873.327          | 873.112 | 871.912          | 871.352 | 870.712 | 870.182 | 869.491          | 868.117 | 866.634 | 866.570 | 866.970          | 866.370 | 865.792 | 861.771 | 
| EXISTING LEVEL (NGL)          | 895.206   | 894.493 | 894.258            | 893.821 | 892.657              | 892.625 | 891.858          | 891.069 | 890.084            | 887.867 | 886.657           | 885.160 | 883.354            | 882.694 | 882.407            | 881.033 | 879.164  | 878.258 | 877.181             | 876.614 | 876.339 | 876.432 | 876.236            | 875.956 | 875.640            | 875.532 | 875.062          | 874.672 | 873.708          | 873.327 | 873.112          | 872.281 | 871.352 | 870.712 | 870.182          | 869.491 | 868.171 | 866.634 | 866.570          | 866.183 | 861.995 | 860.792 | 
| LEVEL DIFF. (FRL - NGL)       | -0.013  | 0.285   | 0.317              | 0.841   | 0.234                | 0.361   | 0.457            | 0.220   | 0.839              | 0.450   | 0.346             | 0.702   | 0.238              | -0.534  | -0.221             | 0.588   | 0.434    | 0.471   | 0.260               | 0.094   | -0.103  | -0.124  | -0.108             | 0.170   | 0.214              | 0.485   | -0.216           | -0.370  | -0.640           | -0.691  | -0.054           | -0.064  | -0.213  | 1.375   | 0.979            | 1.155   | 1.598   | 2.233   | 2.642            | 2.600   | 1.598   | 1.568   | 0.767   | 0.435   | 0.379   | 0.123   | 1.518   | 0.700   | -0.389  | -0.237  | -0.471  |         |         
| HORIZONTAL                    | L=96.8m   |         | R=90.0m<br>L=39.1m |         | R=104.0m<br>L=174.1m |         |                  |         | R=33.0m<br>L=65.9m |         | L=80.0m           |         | R=55.0m<br>L=53.6m |         | R=80.0m<br>L=72.2m |         | L=143.7m |         | R=135.0m<br>L=75.0m |         | L=30.0m |         | R=50.0m<br>L=58.8m |         | R=33.0m<br>L=59.9m |         | L=30.0m          | |
| SUPERELEVATION                | 2.50%   |         | 4.44%              |         | 3.85%                |         |                  |         | 7.00%              |         | 2.50%             |         | 7.00%              |         | 5.00%              |         | 2.50%    |         | 2.96%               |         | 7.00%   |         | 7.00%              |         | 7.00%              |         | 7.00%            | |
| CURVE WIDENING                | 5.9   |         | 5.9                |         | 5.6                  |         |                  |         | 6.5                |         | 6.5               |         | 6.2                |         | 6.2                |         | 5.8      |         | 6.2                 |         | 6.2     |         | 6.5                |         | 6.5                |         | 6.5              | |
| VERTICAL SCHEMATIC            | L=35.0m   |         | L=97.0m<br>G=-3.2  |         | L=30.0m              |         | L=60.0m<br>G=8.0 |         | L=30.0m            |         | L=101.5m<br>G=5.3 |         | L=45.0m            |         | L=92.1m<br>G=1.5   |         | L=45.0m  |         | L=55.0m<br>G=6.0    |         | L=45.0m |         | L=62.5m<br>G=8.0   |         | L=30.0m            |         | L=62.5m<br>G=6.0 |         | L=45.0m<br>G=3.5 |         | L=27.5m<br>G=9.0 |         | L=30.0m |         | L=70.0m<br>G=3.5 |         | L=30.0m |         | L=47.5m<br>G=8.0 |         |         
| WIDENING/IMPROVEMENT PROPOSAL | Widening on Right Side (Valley) with Geometric Improvement<br>BC = 30mm , DBM = 50mm , WMM = 250mm , GSB = 150mm , SG = 500mm (CBR > 8 % @ 97 % of MDD) | |
| CHAINAGE                      | 70+000  | 70+020  | 70+027             | 70+040  | 70+060               | 70+080  | 70+100           | 70+120  | 70+140             | 70+160  | 70+180            | 70+200  | 70+220             | 70+240  | 70+260             | 70+280  | 70+300   | 70+320  | 70+340              | 70+360  | 70+380  | 70+400  | 70+420             | 70+440  | 70+460             | 70+480  | 70+500           | 70+520  | 70+540           | 70+560  | 70+580           | 70+600  | 70+620  | 70+640  | 70+660           | 70+680  | 70+700  | 70+720  | 70+740           | 70+760  | 70+780  | 70+800  | 70+820  | 70+840  | 70+860  | 70+880  | 70+900  | 70+920  | 70+940  | 70+960  | 70+980  | 71+000  |         |         

Notes :  
1) All Levels are in m unless otherwise indicated.

Legend :

|                         |                                   |
|-------------------------|-----------------------------------|
| Proposed CL :           | Existing Road :                   |
| Proposed Edges :        | Existing Hill :                   |
| Contours 20m Interval : | Existing Valley :                 |
| Contours 5m Interval :  | Existing Hill Cutting Line :      |
| Proposed Major Bridge : | Existing Hill Toe Line :          |
| Proposed Minor Bridge : | Existing Valley Line :            |
| Proposed Pipe Culvert : | Important Buildings :             |
| Proposed Slab Culvert : | Other Buildings/Huts/Tile house : |
| Proposed Box Culvert :  | Excavation by Contractor :        |

|          |           |                 |            |          |       |           |                 |
|----------|-----------|-----------------|------------|----------|-------|-----------|-----------------|
| R0       | Sep. 2017 | Tender Drawings | NKM/RJ     | HK       | HK    | NKS & SKB | Tapas Mukherjee |
| Revision | Date      | Stage / Report  | Topography | Designed | Drawn | Checked   | Approved        |

Client : Ministry of Road Transport & Highways (Government of India)

Consultant : RITES LIMITED, RITES BHAWAN, Plot No. 1, Sector- 29, Gurgaon-122001

Project : Preparation of Revised Detailed Project Report and Verification of Executed Quantities/Items for Widening to 2 Lane of Merangkong-Tamlu-Mon Road, Changtongya-Longleng Road, Chakabama-Zunhebot Road & Pftusero-Phek Road under Phase 'A' of SARDP-NE in the State of Nagaland


Scale : Horizontal 1:50, 1:75, 1:100; Vertical 1:5, 1:7.5, 1:10

Title : ALIGNMENT PLAN & PROFILE : MERANGKONG TAMLU MON ROAD

Page No. : MTM - 71


MERANGKONG

MON

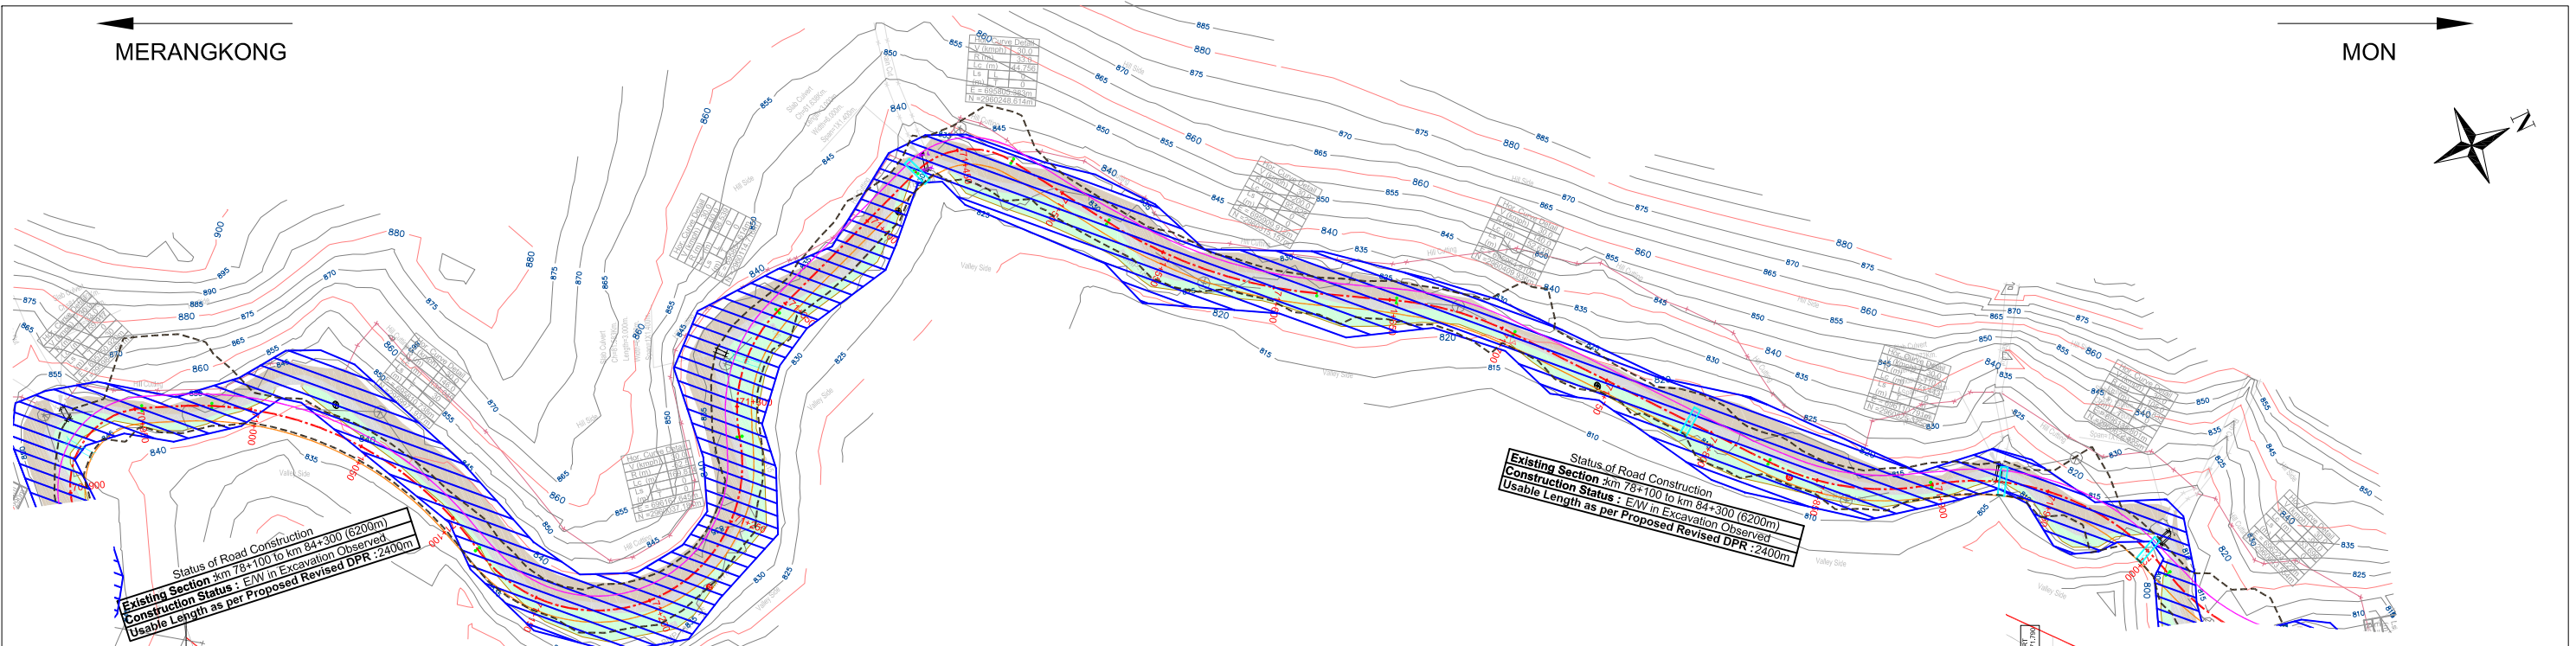

Status of Road Construction  
Existing Section : km 78+100 to km 84+300 (6200m)  
Construction Status : E/W in Excavation Observed  
Usable Length as per Proposed Revised DPR : 2400m

Status of Road Construction  
Existing Section : km 78+100 to km 84+300 (6200m)  
Construction Status : E/W in Excavation Observed  
Usable Length as per Proposed Revised DPR : 2400m

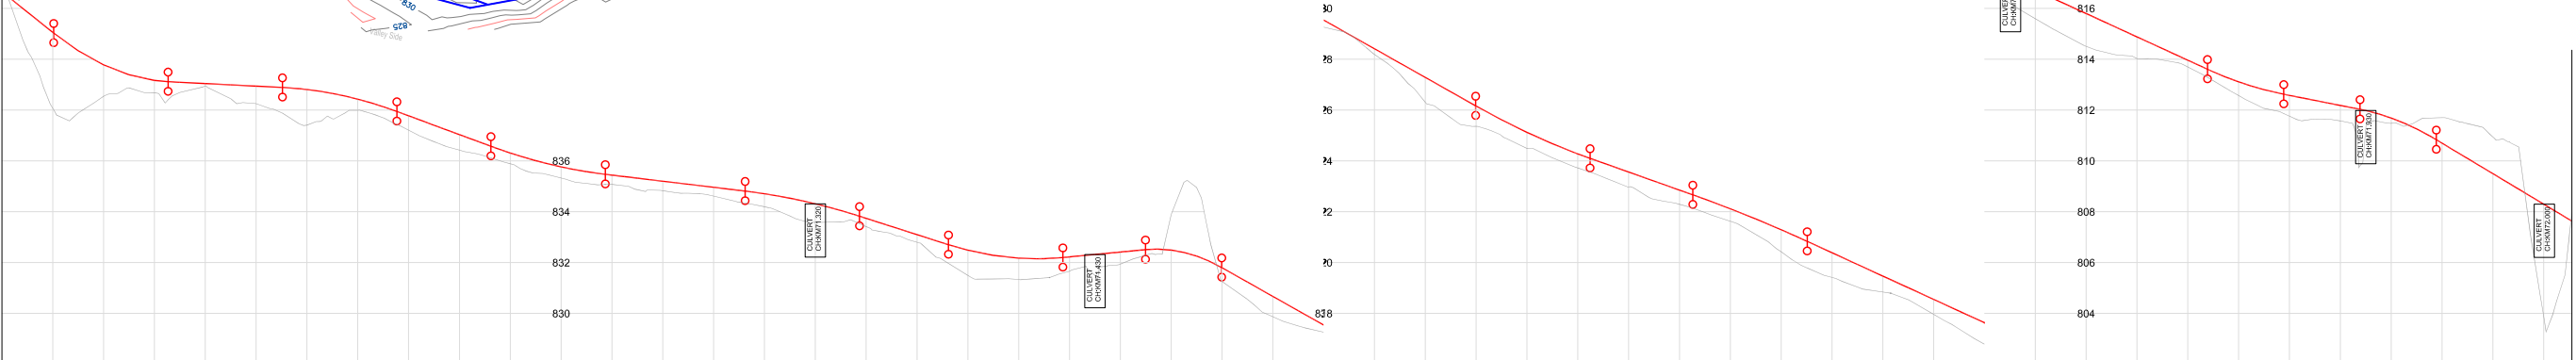

| |
|---|
| PROPOSED LEVEL (FRL)          | 842.037  | 841.057 | 839.778             | 839.165 | 839.041            | 838.941 | 838.808 | 838.429 | 837.773            | 837.033 | 836.309 | 835.765 | 835.441             | 835.201 | 834.960 | 834.707 | 834.311   | 833.739 | 833.100  | 832.488 | 832.173             | 831.659 | 832.224              | 831.941 | 832.414 | 833.898 | 832.492 | 831.257 | 831.798 | 830.670 | 829.

| LEVEL DIFF. (FRL - NGL)       | -1.471   | 2.982   | 1.234               | 0.482   | 0.095              | 0.689   | 1.401   | 0.437   | 0.584              | 0.610   | 0.421   | 0.438   | 0.365               | 0.375   | 0.347   | 0.511   | 0.729   | 0.326   | 0.302    | 0.991   | 0.840               | 0.564   | 0.473                | -1.407  | 0.540   | 0.800   | 0.280   | 0.227   | 0.976   | 0.797   | 0.630   | 0.555   | 0.585             | 0.559   | 0.490   | 0.866   | 0.972   | 0.628   | 0.589   | 0.843   | 1.119   | 1.292   | 0.855   | 0.267   | 0.538   | 0.816   | 0.608   | 0.209   | -1.001  | -1.444  | 4.427   |         |         
| HORIZONTAL                    | R=146.0m<br>L=134.0m                                       |         | R=62.5m<br>L=169.9m |         | R=60.0m<br>L=58.5m |         | L=84.2m |         | R=33.0m<br>L=44.8m |         | L=48.6m |         | R=200.0m<br>L=95.6m |         | L=34.2m |         | R=140.0m<br>L=52.6m                                     |         | L=122.3m |         | R=110.0m<br>L=71.4m |         | R=105.0m<br>L=113.8m | |
| SUPERELEVATION                | 2.74%  |         | 6.40%               |         | 6.67%              |         | 2.50%   |         | 7.00%              |         | 2.50%   |         | 2.50%               |         | 2.50%   |         | 2.86%   |         | 2.50%    |         | 3.64%               |         | 3.81%                | |
| CURVE WIDENING                | 5.6  |         | 5.9                 |         | 6.2                |         | 6.5     |         | 5.6                |         | 5.6     |         | 5.6                 |         | 5.6     |         | 5.6   |         | 5.6      |         | 5.6                 |         | 5.6                  | |
| VERTICAL SCHEMATIC            | 7.5m   |         | L=45.0m             |         | L=45.0m            |         | L=37.0m |         | L=45.0m            |         | L=55.0m |         | L=45.0m             |         | L=35.0m |         | L=45.0m   |         | G=1.0    |         | L=32.5m             |         | L=30.0m              |         | L=99.9m |         | L=45.0m |         | L=40.4m |         | L=45.0m |         | L=157.5m          |         | L=30.0m |         | L=30.0m |         | L=30.0m |         | L=30.0m |         | L=70.0m |         |         
| WIDENING/IMPROVEMENT PROPOSAL | Widening on Right Side (Valley) with Geometric Improvement |         |                     |         |                    |         |         |         |                    |         |         |         |                     |         |         |         | Widening on Left Side (Hill) with Geometric Improvement |         |          |         |                     |         |                      |         |         |         |         |         |         |         |         |         | Widening on Right | |
| CHAINAGE                      | 71+000   | 71+020  | 71+040              | 71+060  | 71+080             | 71+100  | 71+120  | 71+140  | 71+160             | 71+180  | 71+200  | 71+220  | 71+240              | 71+260  | 71+280  | 71+300  | 71+320  | 71+340  | 71+360   | 71+380  | 71+400              | 71+420  | 71+440               | 71+460  | 71+480  | 71+500  | 71+520  | 71+540  | 71+560  | 71+580  | 71+600  | 71+620  | 71+640            | 71+660  | 71+680  | 71+700  | 71+720  | 71+740  | 71+760  | 71+780  | 71+800  | 71+820  | 71+840  | 71+860  | 71+880  | 71+900  | 71+920  | 71+940  | 71+960  | 71+980  | 72+000  |         |         

Notes :  
1) All Levels are in m unless otherwise indicated.

Legend :

|                         |  |                                   |  |
|-------------------------|--|-----------------------------------|--|
| Proposed CL :           |  | Existing Road :                   |  |
| Proposed Edges :        |  | Existing Hill :                   |  |
| Contours 20m Interval : |  | Existing Valley :                 |  |
| Contours 5m Interval :  |  | Existing Hill Cutting Line :      |  |
| Proposed Major Bridge : |  | Existing Hill Toe Line :          |  |
| Proposed Minor Bridge : |  | Existing Valley Line :            |  |
| Proposed Pipe Culvert : |  | Important Buildings :             |  |
| Proposed Slab Culvert : |  | Other Buildings/Huts/Tile house : |  |
| Proposed Box Culvert :  |  | Excavation by Contractor :        |  |

|          |           |                 |            |          |       |           |                 |
|----------|-----------|-----------------|------------|----------|-------|-----------|-----------------|
| R0       | Sep. 2017 | Tender Drawings | NKM/RJ     | HK       | HK    | NKS & SKB | Tapas Mukherjee |
| Revision | Date      | Stage / Report  | Topography | Designed | Drawn | Checked   | Approved        |

Client : Ministry of Road Transport & Highways (Government of India)

Consultant : RITES LIMITED, RITES BHAWAN, Plot No. 1, Sector- 29, Gurgaon-122001

Project : Preparation of Revised Detailed Project Report and Verification of Executed Quantities/Items for Widening to 2 Lane of Merangkong-Tamlu-Mon Road, Changtongya-Longleng Road, Chakabama-Zunhebot Road & Pftusero-Phek Road under Phase 'A' of SARDP-NE in the State of Nagaland


Scale : Horizontal 0 50 75 100, Vertical 0 5 7.5 10

Title : ALIGNMENT PLAN & PROFILE : MERANGKONG TAMLU MON ROAD

Page No. : MTM - 72

MERANGKONG

MON

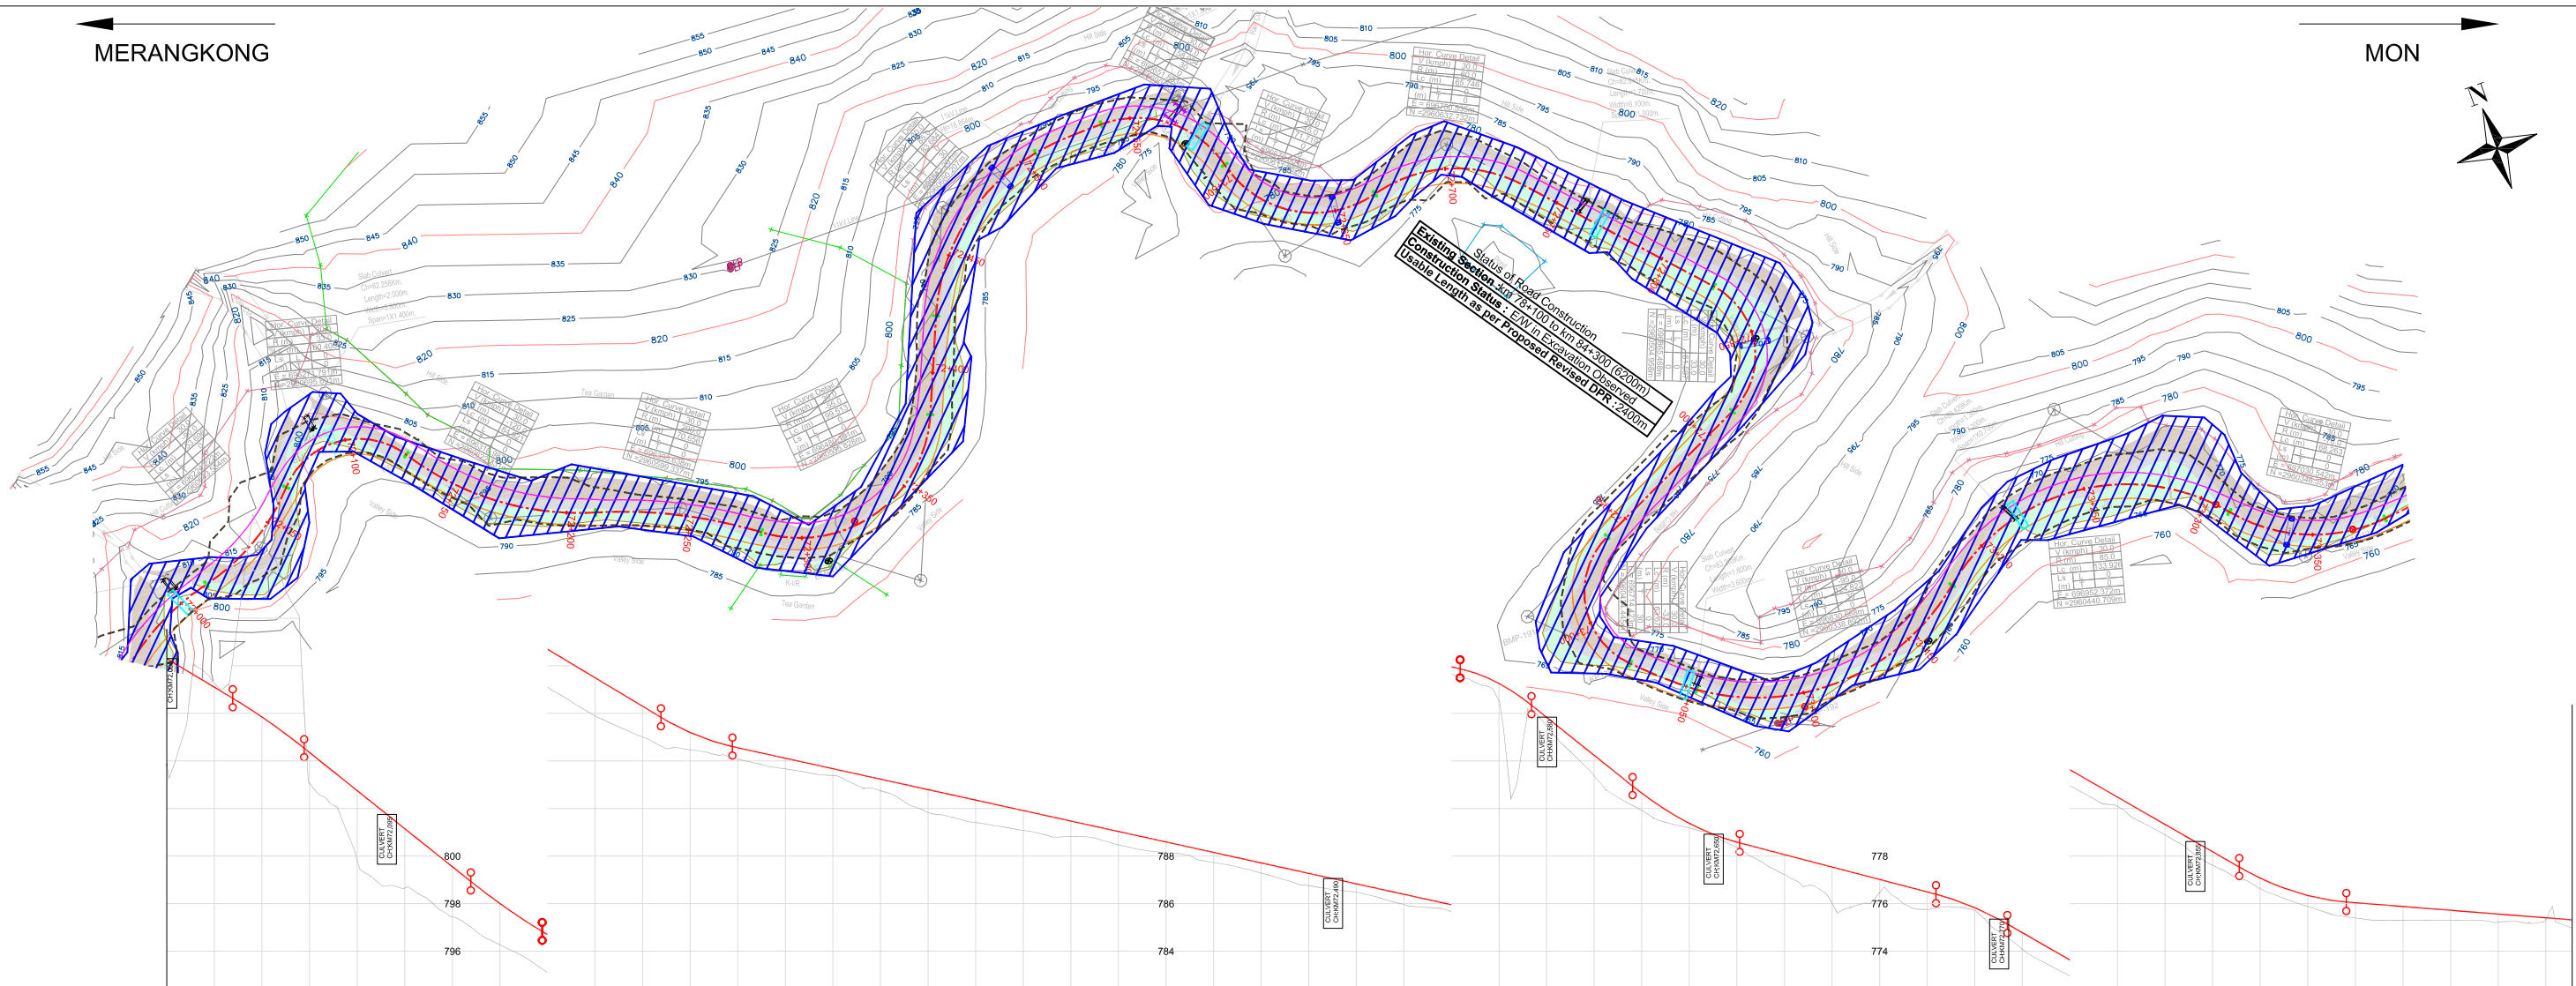

| |
|---|
| PROPOSED LEVEL (FRL)          | 803.239   | 803.971            | 807.098            | 805.848                      | 803.624             | 803.353            | 802.753 | 801.153            | 799.553 | 798.003            | 796.698            | 795.498            | 794.298 | 793.194            | 792.082 | 792.564            | 791.669 | 792.114 | 791.389 | 791.674 | 791.234 | 790.794 | 790.354 | 789.914 | 
| EXISTING LEVEL (NGL)          | 803.971   | 807.261            | 813.624            | 803.056                      | 799.829             | 802.753            | 801.153 | 797.446            | 799.553 | 796.271            | 798.003            | 795.108            | 796.698 | 793.899            | 795.498 | 793.011            | 794.298 | 792.468 | 793.194 | 792.082 | 792.564 | 791.669 | 792.114 | 791.389 | 791.674 | 791.234 | 790.744 | 791.234 | 789.835 | 790.794 | 789.407 | 790.354 | 789.079 | 789.914 | 788.824 | 789.474 | 788.488 | 789.034 | 788.132 | 788.594 | 787.725 | 788.154 | 787.284 | 787.714 | 786.756 | 787.274 | 786.487 | 786.834 | 785.962 | 786.394 | 785.668 | 785.954 | 784.528 | 785.257 | 783.497 | 783.838 | 781.376 | 782.238 | 779.927 | 780.647 | 779.186 | 779.377 | 778.366 | 778.586 | 777.228 | 778.063 | 776.020 | 777.539 | 776.468 | 777.016 | 775.756 | 776.493 | 775.714 | 775.831 | 774.089 | 774.779 | 772.951 | 773.630 | 772.091 | 772.480 | 770.894 | 771.331 | 769.610 | 770.182 | 768.629 | 769.075 | 767.879 | 768.340 | 767.398 | 766.038 | 767.297 | 767.880 | 767.292 | 767.722 | 767.230 | 767.564 | 767.295 | 767.406 |
| LEVEL DIFF. (FRL - NGL)       | 4.427   | -0.163             | -7.775             | 1.297                        | 2.925               | 2.501              | 2.108   | 1.733              | 1.590   | 1.599              | 1.288              | 0.726              | 0.472   | 0.446              | 0.285   | 0.490              | 0.960   | 0.948   | 0.836   | 0.651   | 0.567   | 0.462   | 0.429   | 0.431   | 0.518   | 0.348   | 0.433   | 0.286   | 0.729   | 0.340   | 0.861   | 0.720   | 0.192   | 0.220   | 0.835   | 1.519   | 0.549   | 0.737   | 0.117   | 0.691   | 0.678   | 0.389   | 0.437   | 0.571   | 0.447   | 0.461   | 0.639   | 0.584   | 0.430   | 0.334   | 0.111   | |
| HORIZONTAL                    |   | R=90.0m<br>L=53.7m | R=33.0m<br>L=60.4m | R=120.0m<br>L=84.9m          | R=200.0m<br>L=70.7m | R=55.0m<br>L=99.5m | L=41.6m | R=85.0m<br>L=83.7m | L=30.0m | R=44.0m<br>L=59.0m | R=45.0m<br>L=71.7m | R=60.0m<br>L=65.7m | L=90.7m | R=33.0m<br>L=61.6m | L=74.5m | R=33.0m<br>L=63.7m | |
| SUPERELEVATION                |   | 4.44%              | 7.00%              | 3.33%                        | 2.50%               | 7.00%              | 2.50%   | 4.71%              | 7.00%   | 7.00%              | 6.67%              | 2.50%              | 7.00%   | 2.50%              | 7.00%   | 7.00%              | |
| CURVE WIDENING                |   | 5.9                | 6.5                | 5.6                          | 5.6                 | 6.2                | 5.9     | 6.2                | 6.2     | 6.2                | 6.2                | 6.5                | |
| VERTICAL SCHEMATIC            | 0m  | L=30.0m            | L=70.0m<br>G=-8.0  | L=30.0m<br>L=50.0m<br>G=-6.0 | L=30.0m             | L=305.9m<br>G=-2.2 | L=30.0m | L=42.5m<br>G=-8.0  | L=45.0m | L=82.5m<br>G=-2.6  | L=30.0m            | L=97.5m<br>G=-5.7  | L=45.0m | L=155.0m<br>G=-0.8 | |
| WIDENING/IMPROVEMENT PROPOSAL | Widening on Right Side (Valley) with Geometric Improvement<br>BC = 30mm, DBM = 50mm, WMM = 250mm, GSB = 150mm, SG = 500mm (CBR > 8% @ 97% of MDD) | |
| CHAINAGE                      | 72+000  | 72+020             | 72+040             | 72+060                       | 72+080              | 72+100             | 72+120  | 72+140             | 72+160  | 72+180             | 72+200             | 72+220             | 72+240  | 72+260             | 72+280  | 72+300             | 72+320  | 72+340  | 72+360  | 72+380  | 72+400  | 72+420  | 72+440  | 72+460  | 72+480  | 72+500  | 72+520  | 72+540  | 72+560  | 72+580  | 72+600  | 72+620  | 72+640  | 72+660  | 72+680  | 72+700  | 72+720  | 72+740  | 72+760  | 72+780  | 72+800  | 72+820  | 72+840  | 72+860  | 72+880  | 72+900  | 72+920  | 72+940  | 72+960  | 72+980  | 73+000  | |

Notes :  
1) All Levels are in m unless otherwise indicated.

|                         |                                   |
|-------------------------|-----------------------------------|
| Proposed CL :           | Existing Road :                   |
| Proposed Edges :        | Existing Hill :                   |
| Contours 20m Interval : | Existing Valley :                 |
| Contours 5m Interval :  | Existing Hill Cutting Line :      |
| Proposed Major Bridge : | Existing Hill Toe Line :          |
| Proposed Minor Bridge : | Existing Valley Line :            |
| Proposed Pipe Culvert : | Important Buildings :             |
| Proposed Slab Culvert : | Other Buildings/Huts/Tile house : |
| Proposed Box Culvert :  | Excavation by Contractor :        |

|          |           |                 |            |          |       |           |                 |
|----------|-----------|-----------------|------------|----------|-------|-----------|-----------------|
| R0       | Sep. 2017 | Tender Drawings | NKM/RJ     | HK       | HK    | NKS & SKB | Tapas Mukherjee |
| Revision | Date      | Stage / Report  | Topography | Designed | Drawn | Checked   | Approved        |

Client : Ministry of Road Transport & Highways (Government of India)



Consultant : RITES LIMITED, RITES BHAWAN, Plot No. 1, Sector- 29, Gurgaon-122001

Project : Preparation of Revised Detailed Project Report and Verification of Executed Quantities/Items for Widening to 2 Lane of Merangkong-Tamlu-Mon Road, Changtongya-Longleng Road, Chakabama-Zunhebot Road & Pftusero-Phek Road under Phase 'A' of SARDP-NE in the State of Nagaland

Scale : Horizontal 1:50, 1:75, 1:100; Vertical 1:5, 1:7.5, 1:10

Title : ALIGNMENT PLAN & PROFILE : MERANGKONG TAMLU MON ROAD

Page No. : MTM - 73

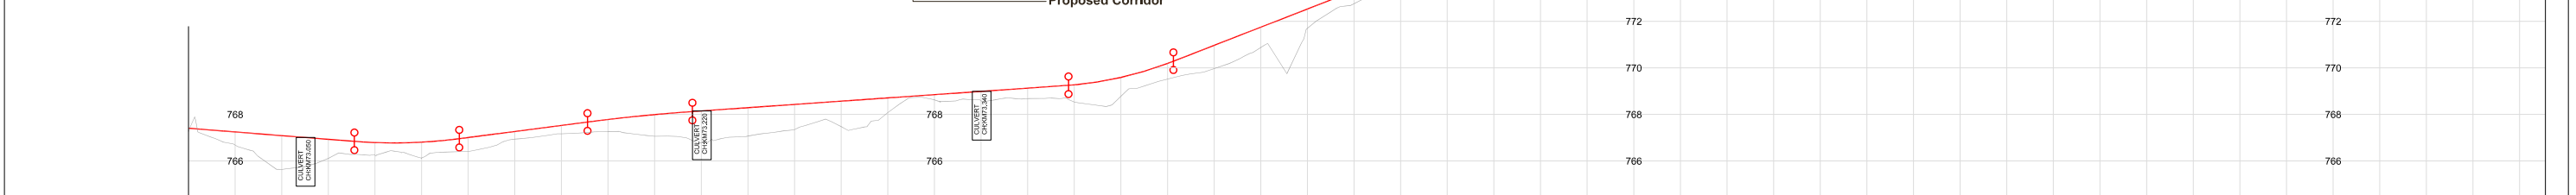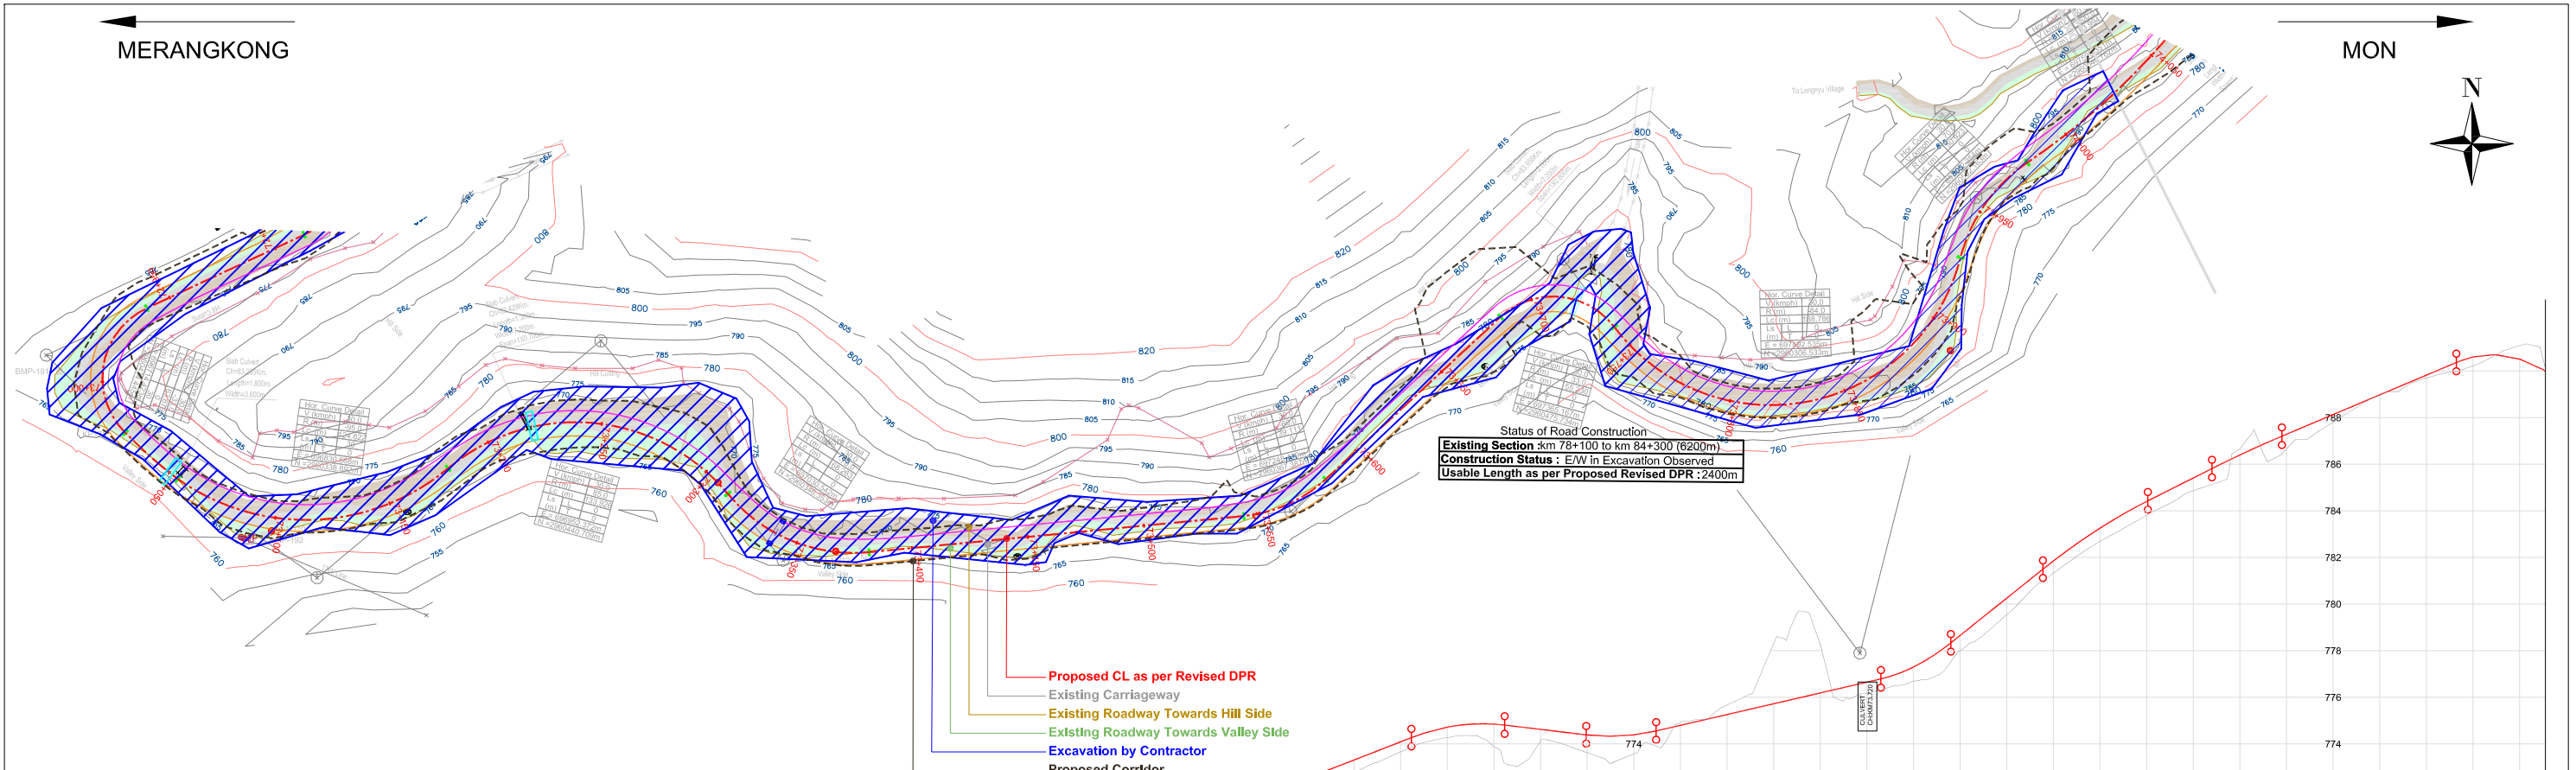

| |
|---|
| PROPOSED LEVEL (FRL) | 767.409 | 767.248 | 767.090 | 766.932 | 766.792 | 766.809 | 766.608 | 766.268 | 767.528 | 767.783 | 767.993 | 768.150 | 768.290 | 768.430 | 768.570 | 768.710 | 768.850 | 768.990 | 
| EXISTING LEVEL (NGL) | 767.299 | 766.685 | 765.637 | 766.115 | 766.251 | 766.128 | 766.417 | 766.939 | 767.170 | 767.285 | 767.063 | 766.779 | 767.071 | 767.351 | 767.478 | 768.079 | 768.625 | 768.586 | 768.692 | 768.535 | 768.272 | 768.518 | 768.778 | 769.071 | 769.380 | 769.700 | 770.030 | 770.370 | 770.710 |

